Sta 62+65 I of line bar up the North bank
Ogden River see Page 32 Transit Book

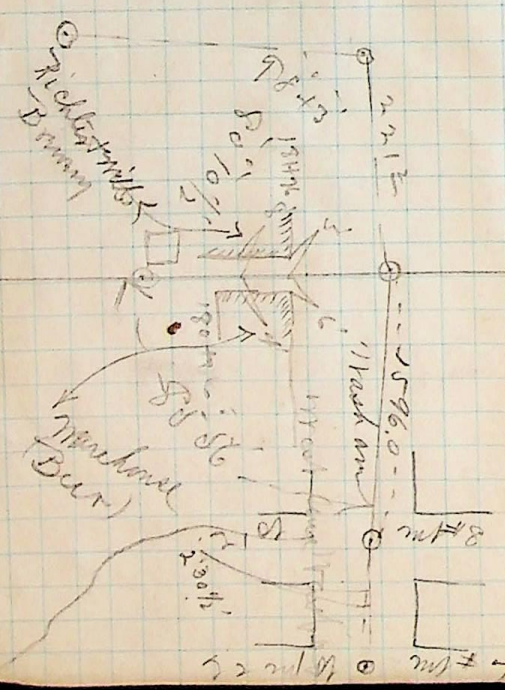

A. F. PARKER.