


Drawn and For Sale by
T. A. PERKINS,
 Surveyor and Draughtsman,
 P. O. Box 316. Ogden, Utah

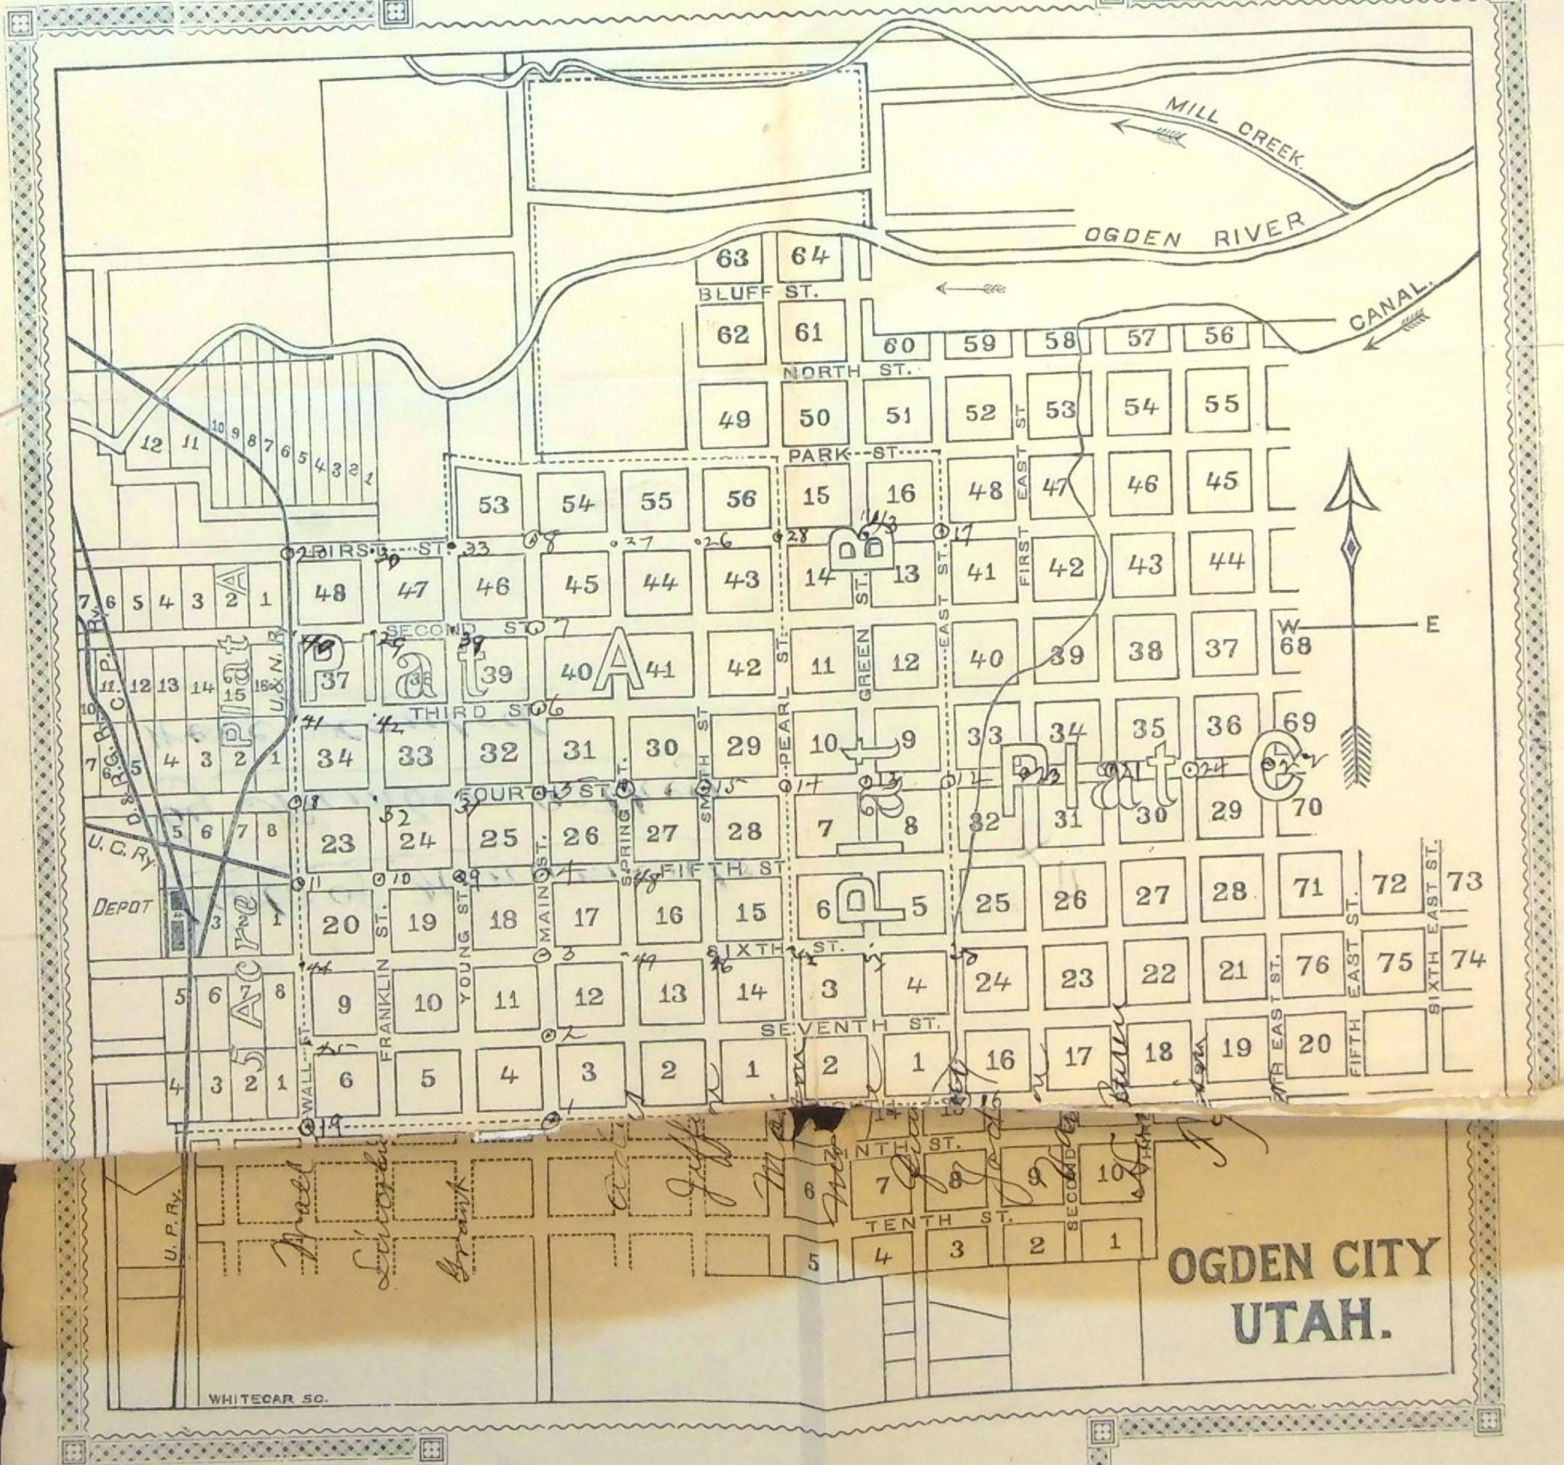

**OGDEN CITY
 UTAH.**

WHITECAR 50.