

23+60

23+80

25+80

25

26

See sketch below

See Page 11 Transit Book I

Line runs S of S rail track

34+89

35+05 @ 19" 74' L

37

38

39

40

41

42+00

46+20

47+50

48+85


49+95

50

51+50

51+99

B.35  
A. F. PARKER

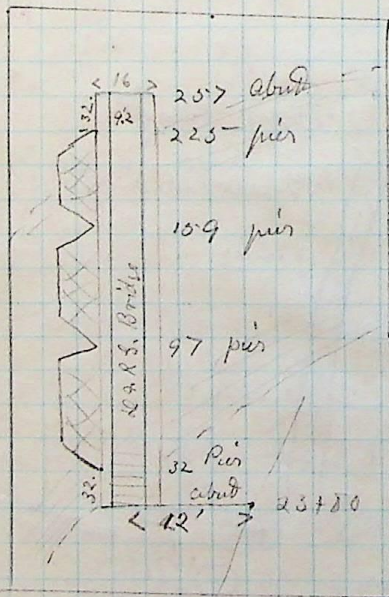

East bank of river

= End of line

Cross at Res.

40.0 South to Riv

P.C. of curve

Track (center)

to left S. R. S.

Course produced

44.0 South of S rail S. R. S. notched tie

50.0

50.0

50.0

20.0

20.0

90.0 South East bank River

81.0 South to elong

10.0 " "

12.0 South to bank

40.0 South to East bank

40.0 South to cor fence

Cross at abut 2000

= 2.5' notch of fence

B.35

A. F. PARKER

