


A. F. PARKER.

A. F. PARKER.


57+35.00' @

B 36

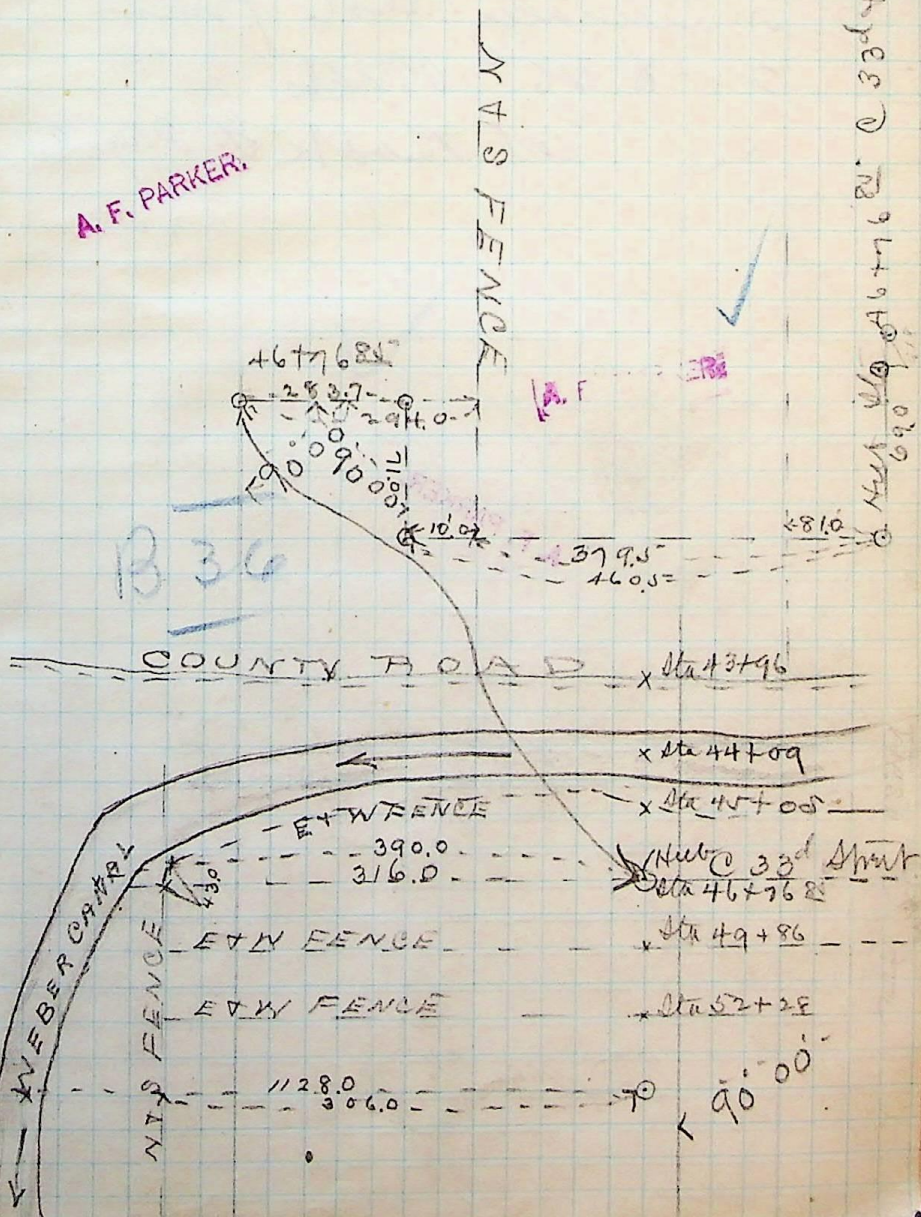

Sta 49+86 @ 33d Street