


Monday P.M. Oct 7th 1889
 Survey for the location of
 Building preparatory to the
 opening of 33.0 ft Street through
 Block 26 from 25th to 24th Streets
See diagram

A. F. PARKER.

A. F. PARKER.

25th ST

Continued on Page 18

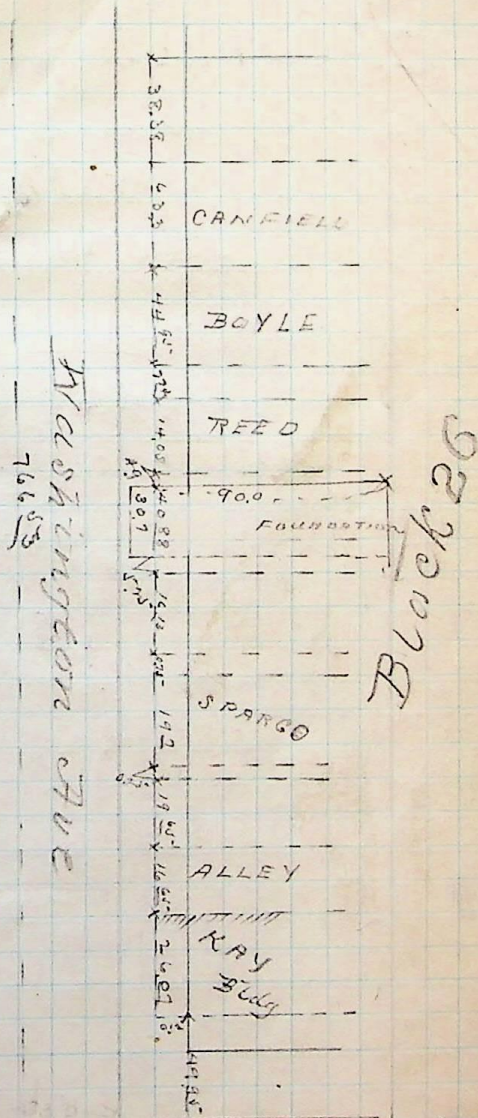

WASHINGTON AVE
76.53

Block 26

107 + 624