


24<sup>th</sup> Street

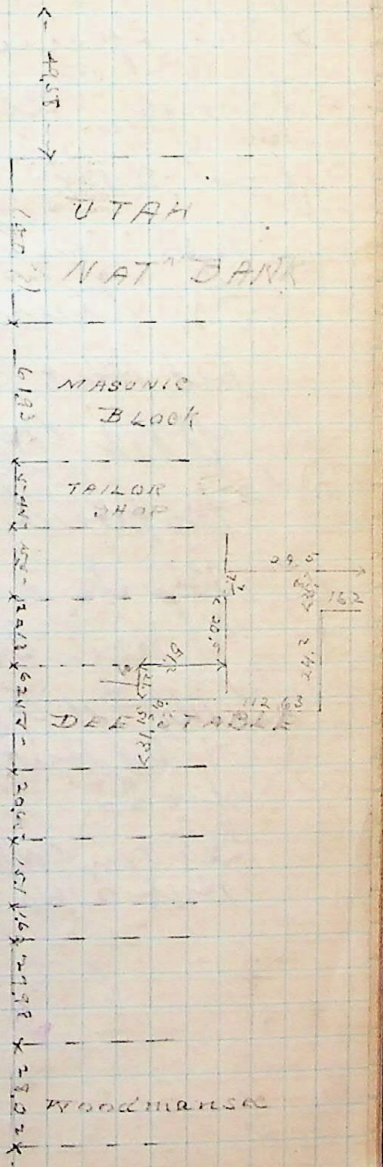

A. F. PARKER



Continued from Page 17