

25th

Street


482

14780

A. F. PARKER

A. F. PARKER

Continued from Page 19

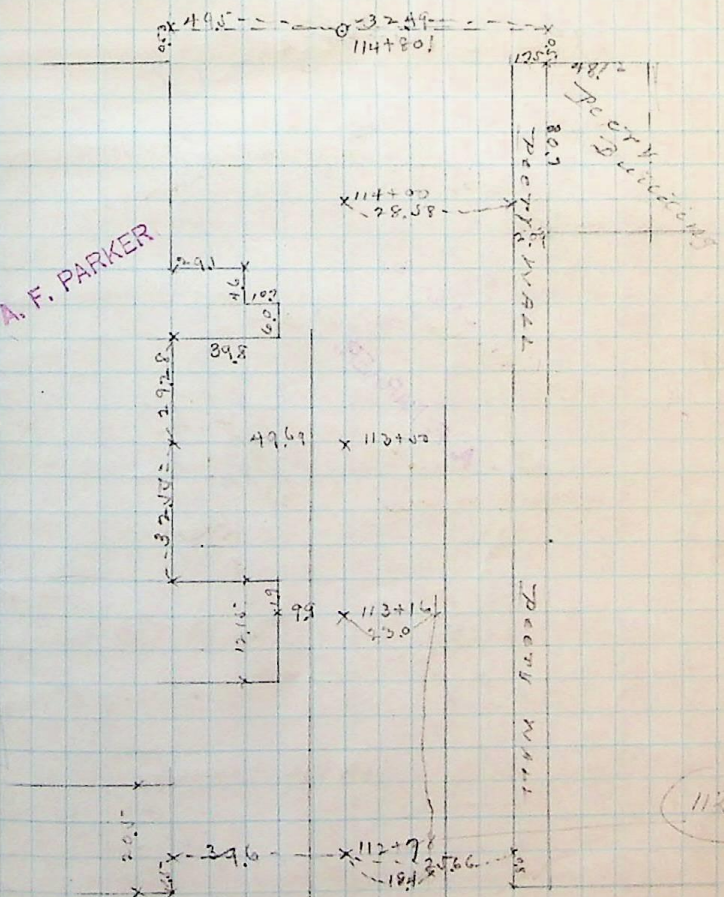

112+78 P