


21st Street & Adams Avenue
 Planted Monument # 27 Centre of
 Tuesday Am. Oct 22nd, 1889

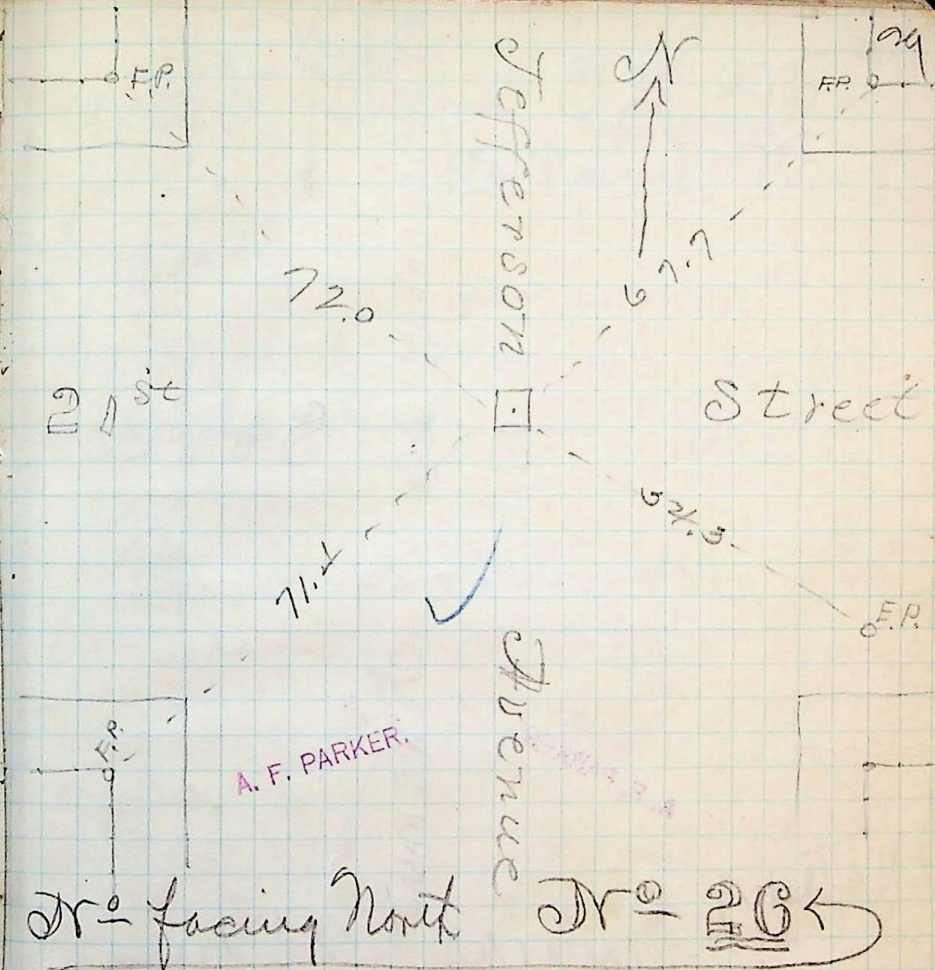

(See note on page 30 in regard
 to mt # 20)

21st Street & Jefferson Avenue
 Planted Monument # 26 Centre
 Tuesday Am. Oct 22nd, 1889