


I South +
 Street 10th R (repeated)
 1 off ~~back~~ of ~~main~~ am
 of ~~house~~ P.O. on ~~has~~

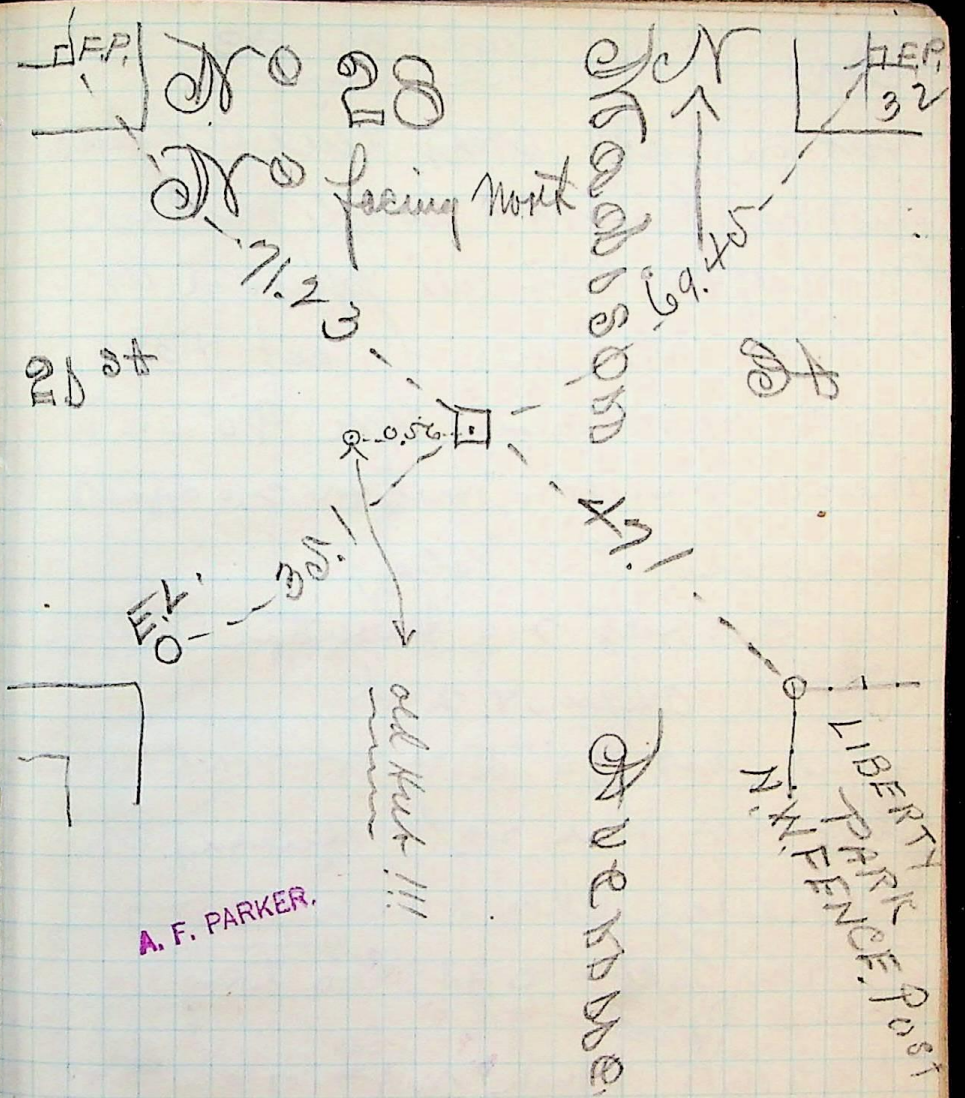

Thursday PM Oct 22 1889