Wednesday Am. Oct 30th, 1889
Locating Brick buildings
on Union Square
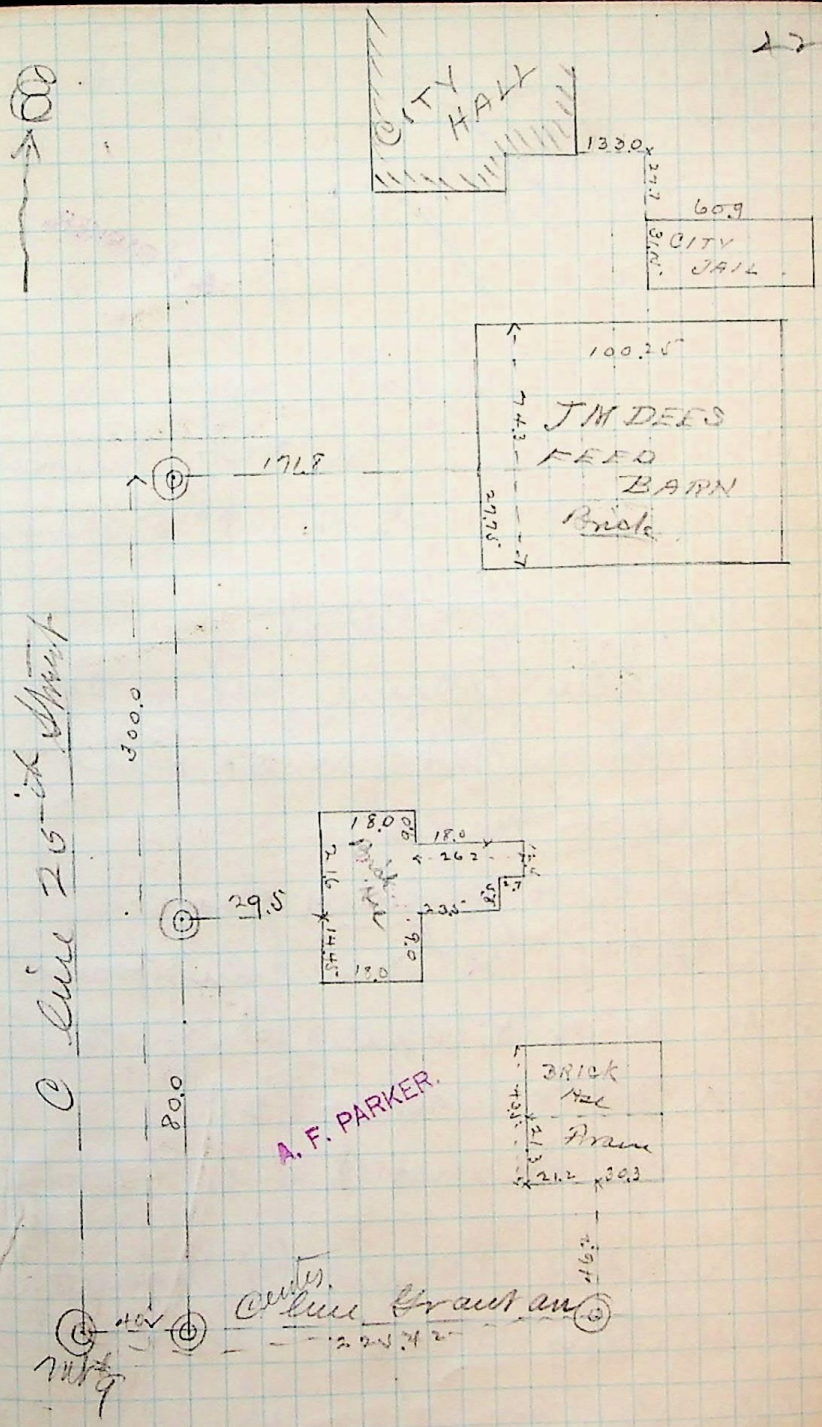
A. F. PARKER.