B37

A. F. PARKER.
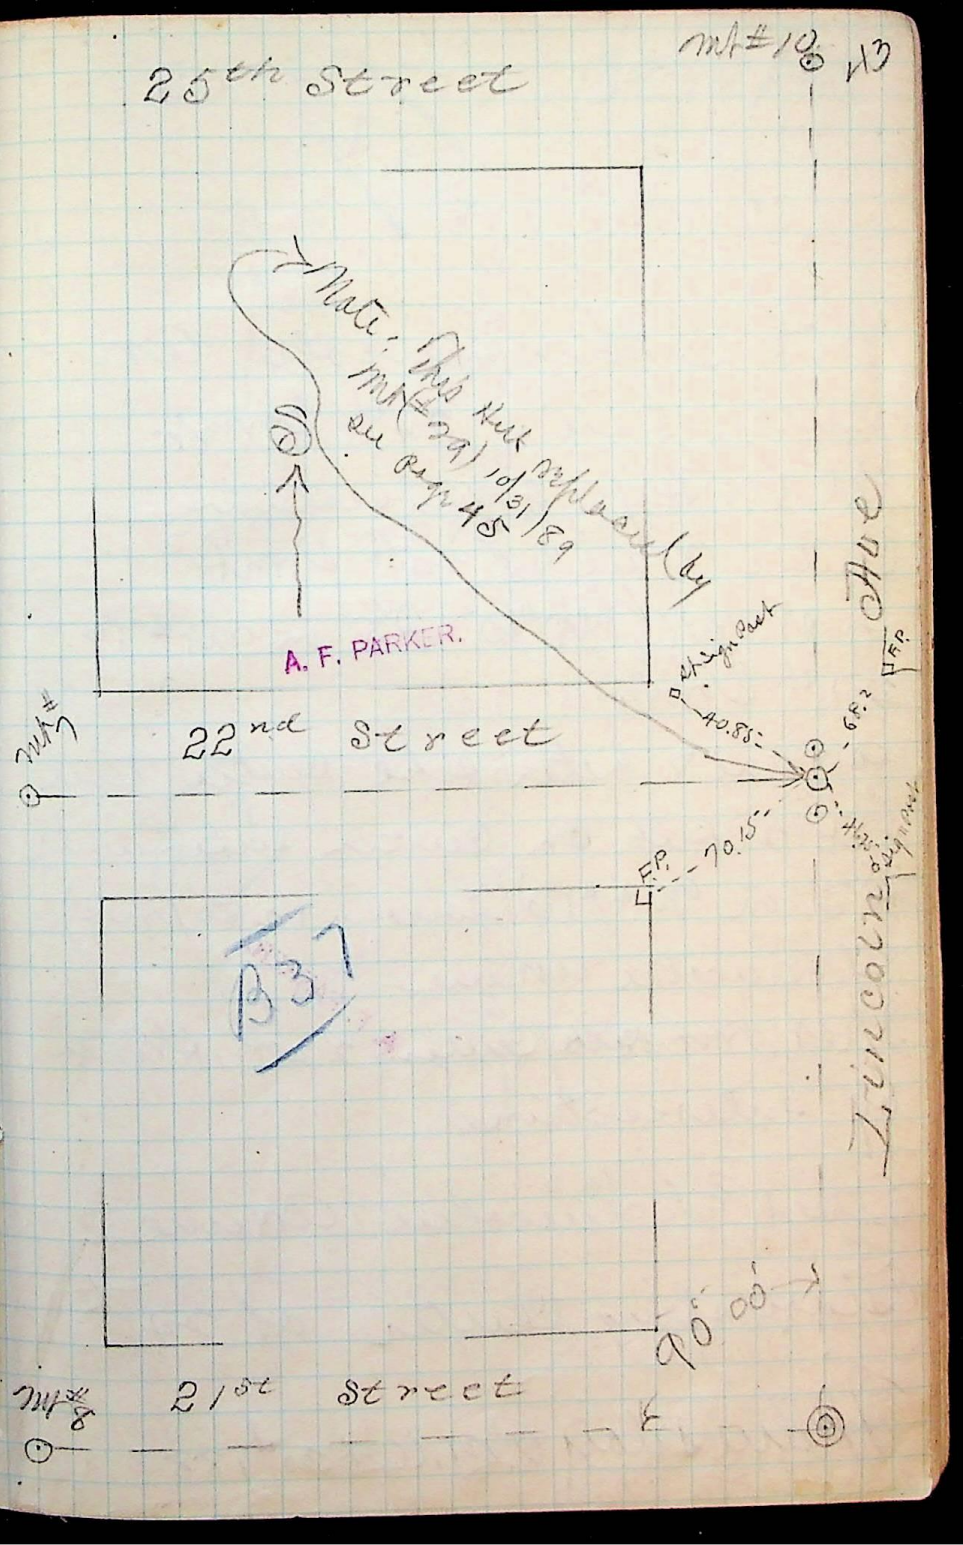
East ℄ line Lincoln Avenue
90° 00 R. (repeated) and West Intersection
Just rear Mk# 7 B.S. on Mk# 5 thence
℄ line of 22nd Street
on Lincoln Avenue either side
thence B.S. on Mk# 10 set Hub
by repeated angles
this has to be absolutely correct
on to Mk# 10 (38th & Lincoln) found
thence 90°00 R. (repeated) & South
B.S. on Mk# 8 (Wrapan & 21st)
Just rear old Hub C of 21st & Lincoln
Red Lincoln Avenue by Intersection
Establishing Centre of 22nd Street
Westwardly P.M. Oct 30th 1889