

1937


With C line Lincoln Ave  
Center line of 24th Street  
and set Hub Intersection  
Center wall and 24th Street  
Just over Mt #5 P.D. on mt #18  
24th Street

across & either side Center line  
Set 2 Hub on Center line Lincoln  
P.D. on mt #10 (Lincoln + 25th Street)  
and Lincoln Avenue  
Just over Hub Center 22nd Street  
by Intersection.

Street and Lincoln Avenue  
Establishing Center of 24th

Wednesday P.M. Oct 30th 1889

Washington Ave  
Mt #5 - Ave

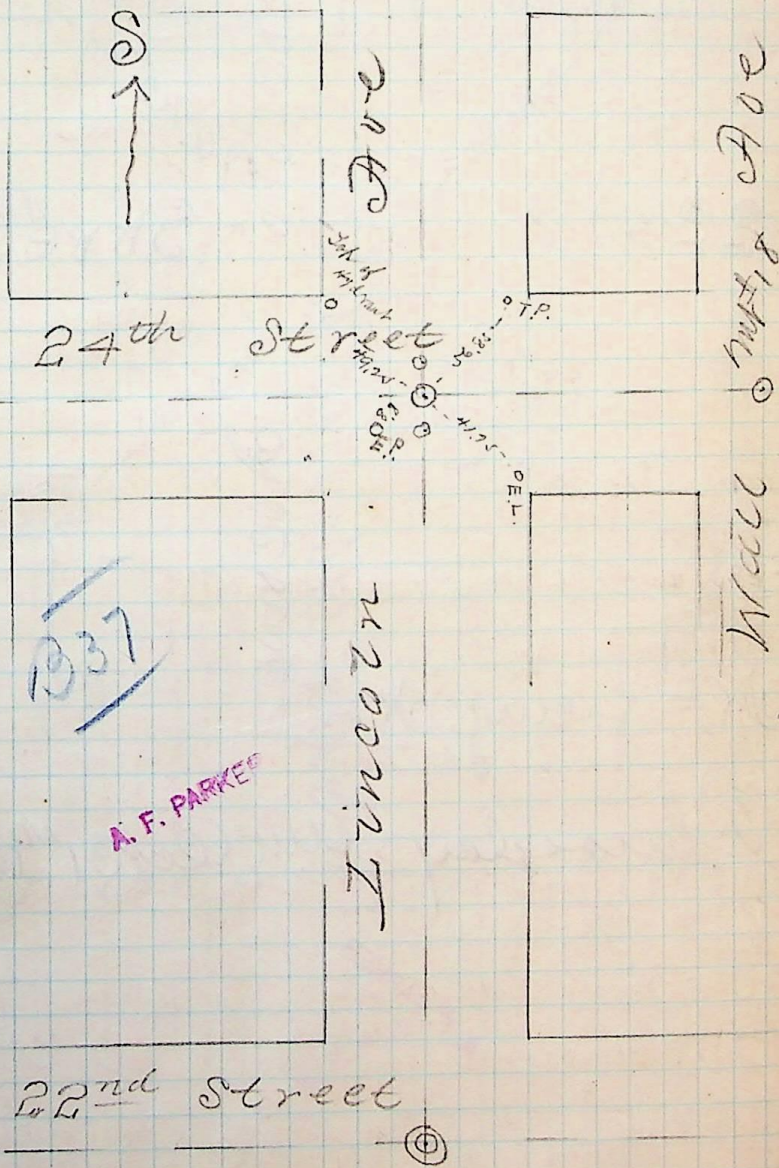

22nd Street