


Thursday Aug Oct 31st 1889

A. F. PARKER.

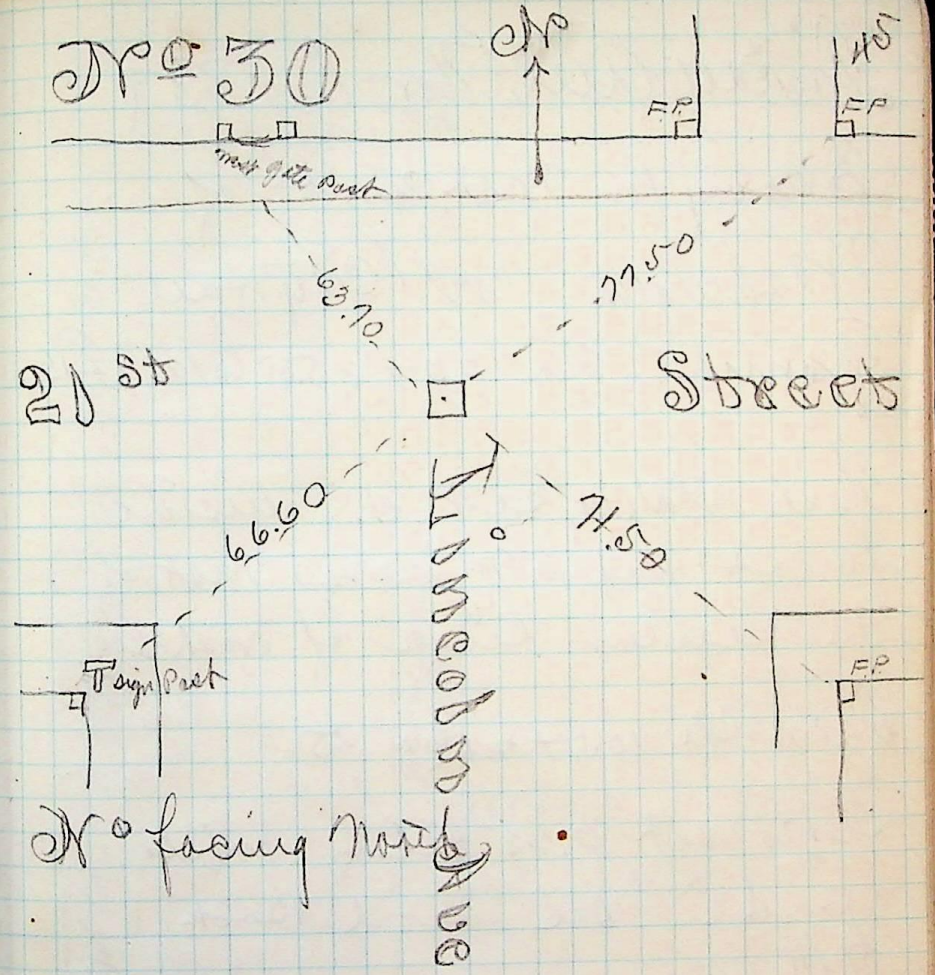

Thursday Aug Oct 31st 1889

A. F. PARKER.