


No 33

No facing north

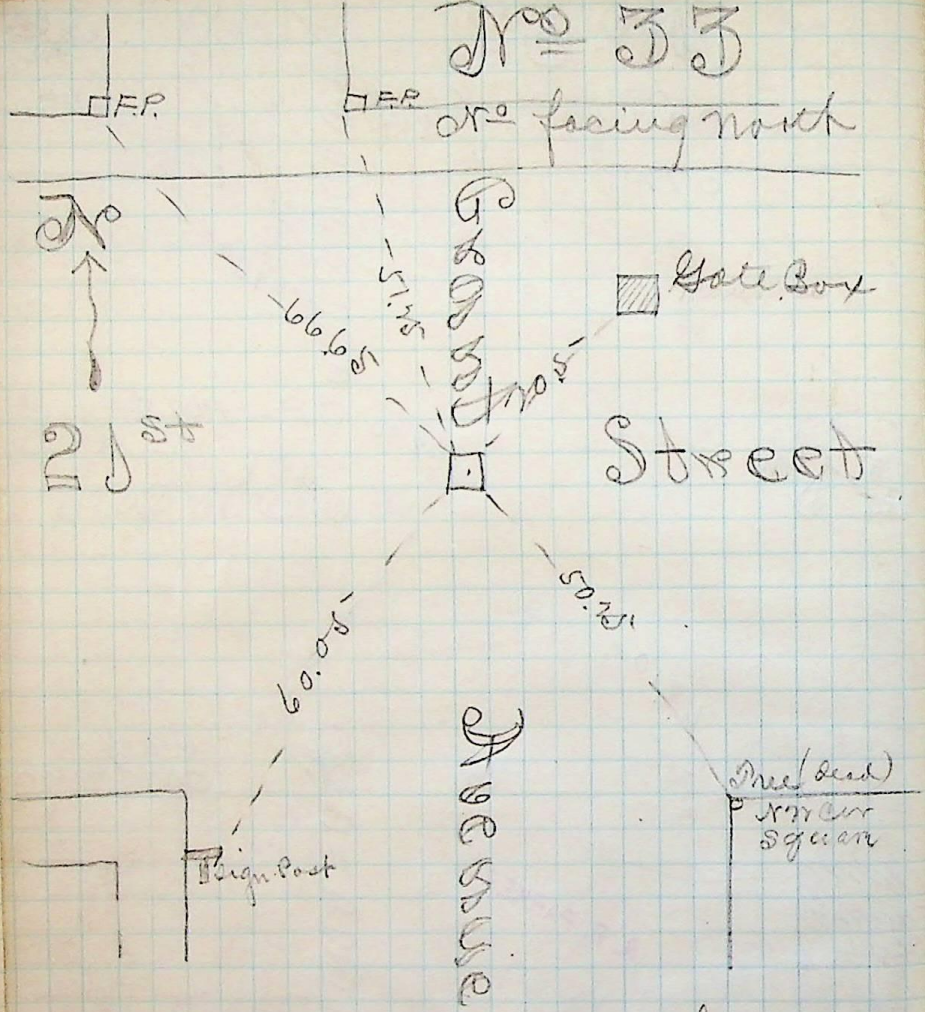

Saturday AM. Nov 2nd 1889

A. F. PARKER.