

For more done Monday night see Page 53

(on old dump)

23<sup>d</sup> St Hubs not referenced  
of 23<sup>d</sup> + 22<sup>nd</sup> streets

Set Hubs either side @ line

Just on mt# 20 Sid on mt# 11  
of 23<sup>d</sup> street

Set Hubs either side @ line

Just on mt# 30 Sid on mt# 10

diagram to

line 23<sup>d</sup> + 22<sup>nd</sup> streets as per

And set Hubs either side of center

Just on mt# 33 Sid on mt# 9

22<sup>nd</sup> street


Set either side of center line of 23<sup>d</sup> St  
on center line of Grant Avenue

Setting Intersection Hubs

Saturday PM. Nov 2nd 1889

A. F. PARKER.

B36

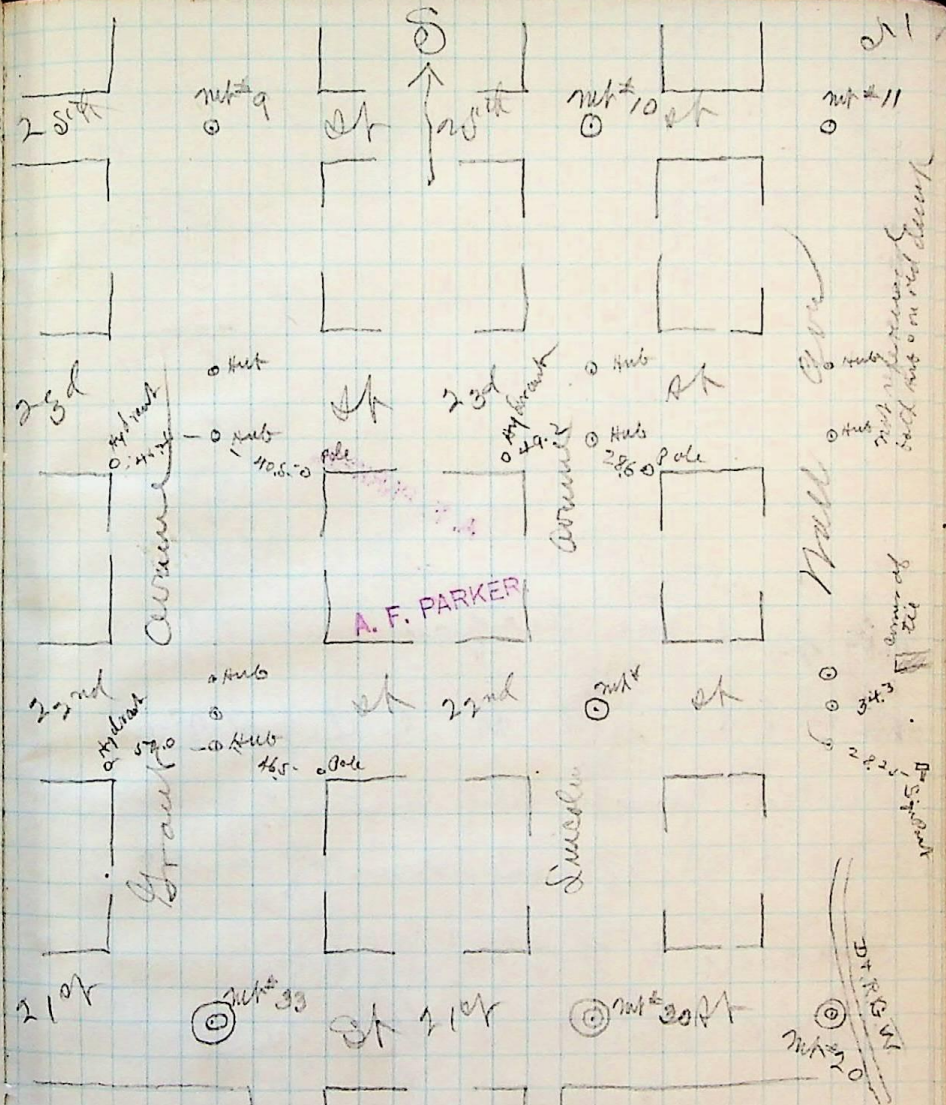

North Hubs only referenced

B36