



Wednesday Am. Nov 6th 1879

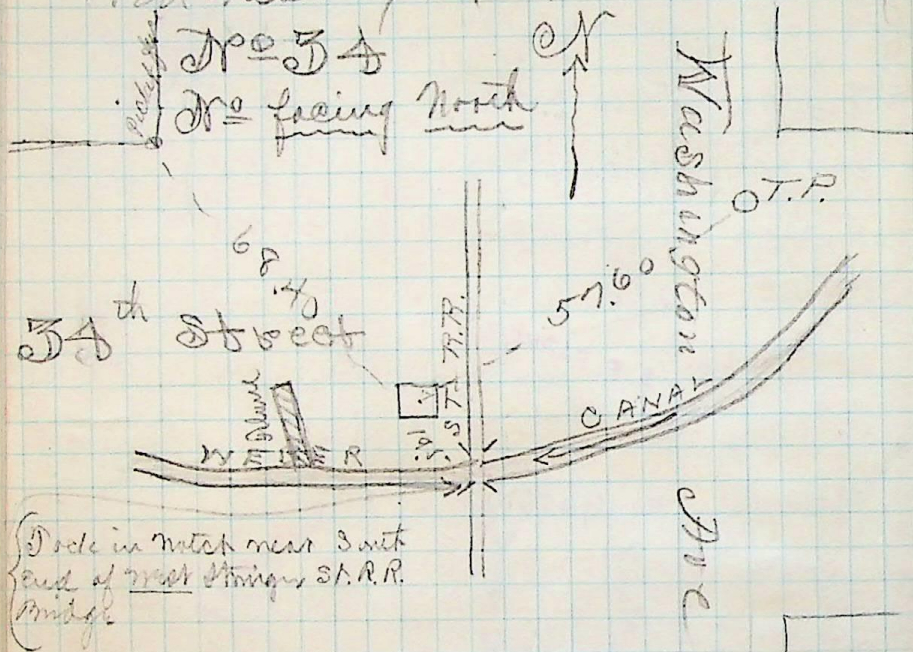

Wednesday Am. Nov 6th, 1879

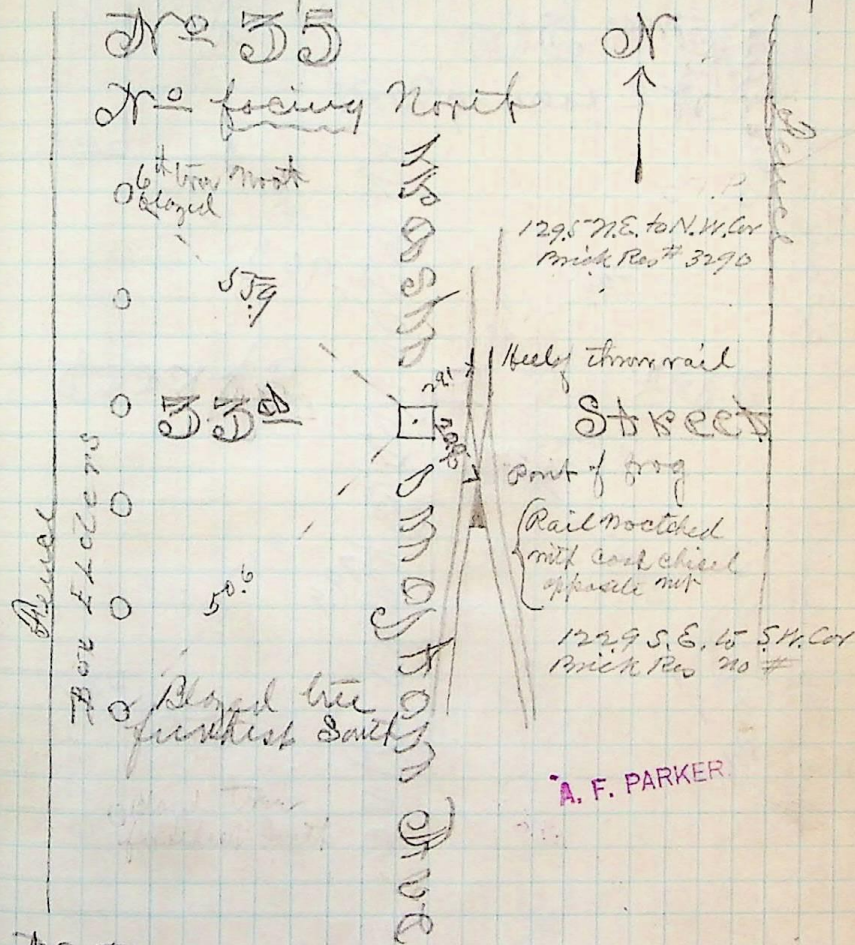

Note:
See Page 30 for note in regard to mt # 20 (32nd st - Washington avenue)