


Wednesday Aug. 11th 1889

No 36

No facing north

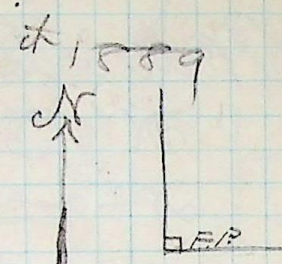

Art. S. fence

Box Elder

399

30th

Washington Drive

90.9


Street

315

Box Elder

79.9

07.0

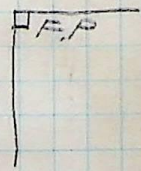


A. F. PARKER.

Wednesday Aug. 11th 1889

57

No 37

No facing north

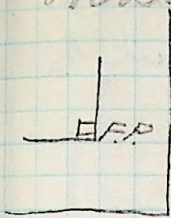

Box Elder


74.1

30th

Washington Drive

EL POLE

28.4

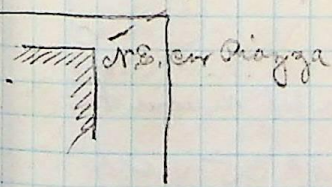

MS. or Piazza

art. S. fence

A. F. PARKER.