



Wednesday P.M. Nov 6th 1889
No 25
Dr. facing North

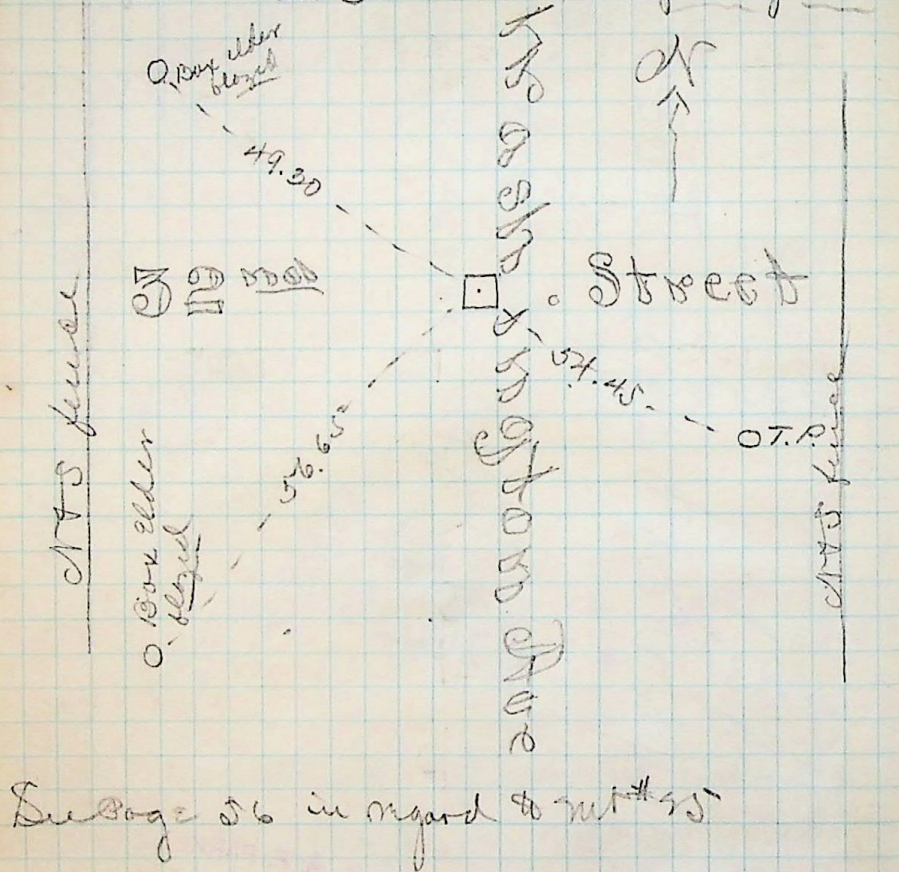

A. F. PARKER.

Wednesday P.M. Nov 6th 1889
No 39
Dr. facing North

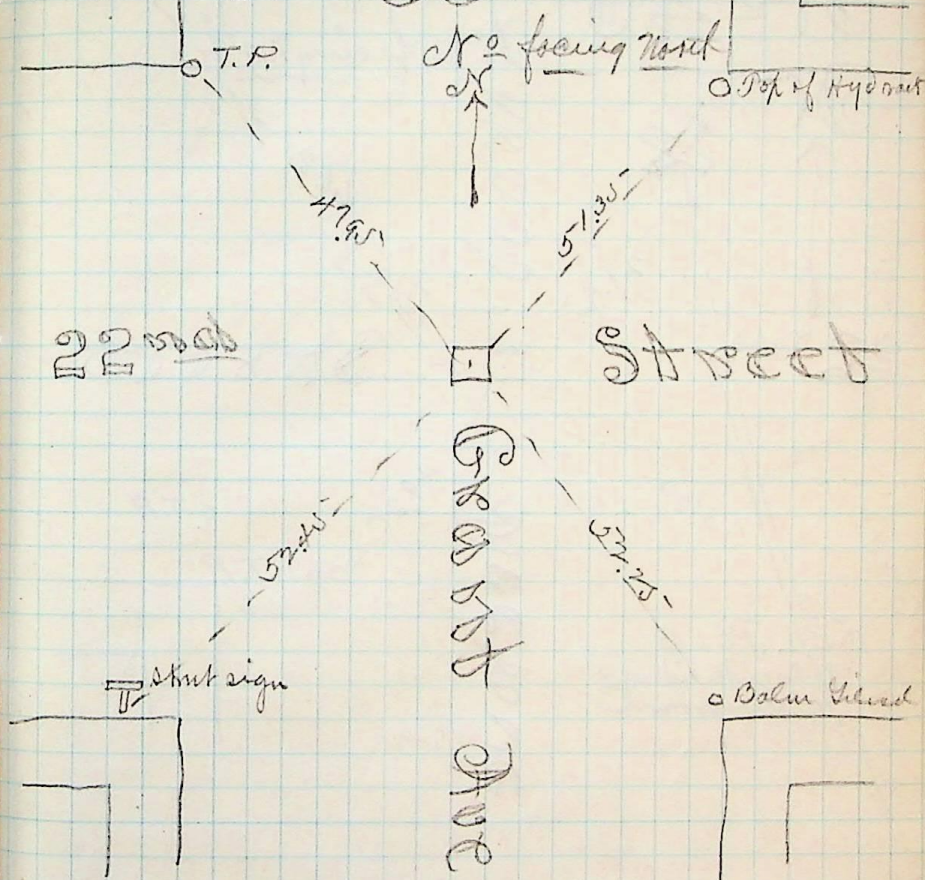

A. F. PARKER.