

25


R.T. T.P.


Sign Post



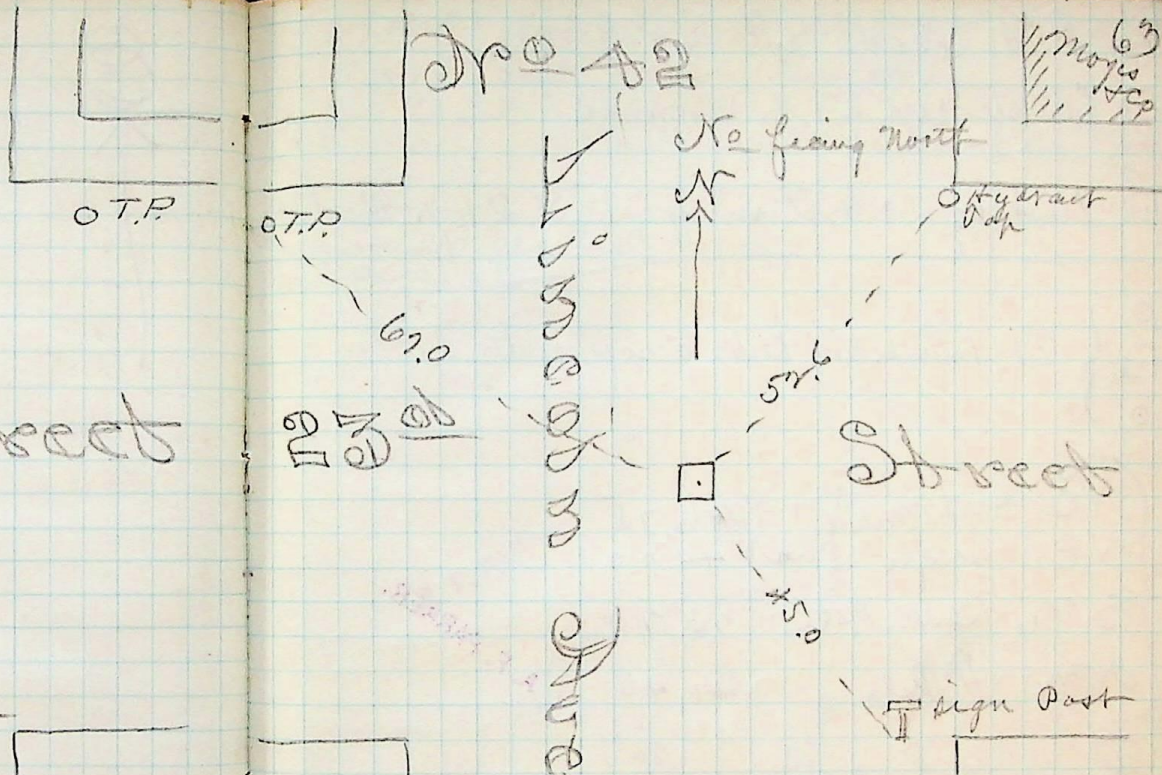



