A. F. PARKER.

B37
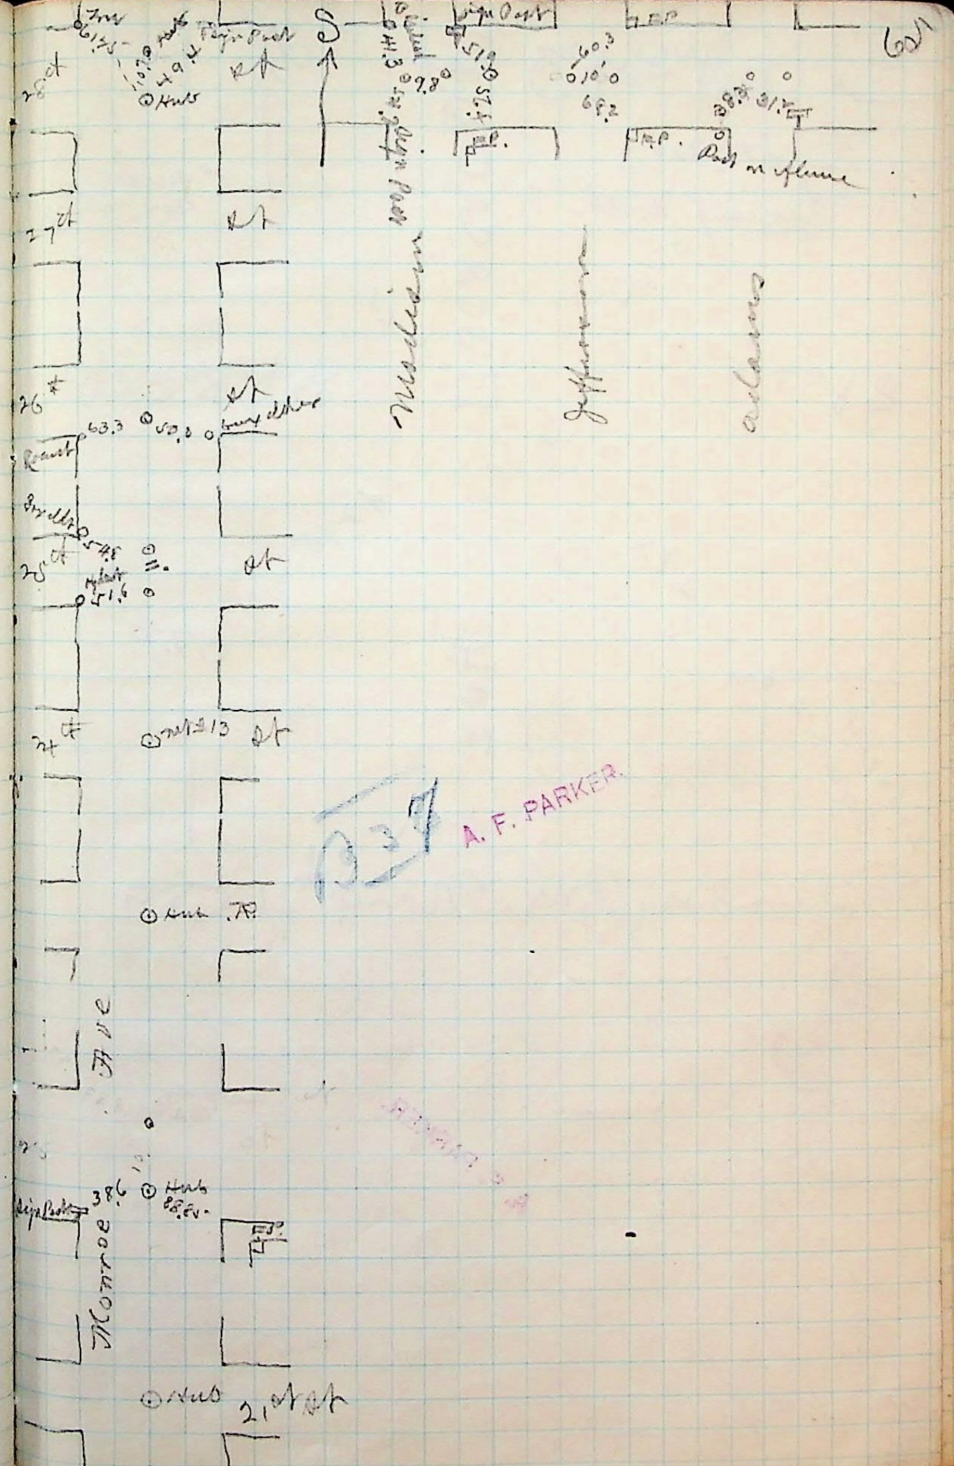
outer side C line 22nd & Monroe
on Hub C 21st & Monroe set Hubs
Just over Mt # 13 24th & Monroe F.S.
28th Streets.
line Monroe avenue from 21st to
Setting Intersection Hubs Center
Saturday Am. Nov 9th 1889