

up 26th & 27th Streets

Hubbs Intersecting like formerly ran
thence just over this hub & set
(see diagram & reference)


arrive & in front of white barn
& set Hub top of Hill C of Jefferson
Jefferson and 27th St double central
cut 24th St Street A.S. on mt # 26

thence just over mt # 15 Jefferson
C line 27th St Street

Center line Jefferson A.F. PARKER on
lifted up & set Hub^o either side
A.S. on mt # 2 (Markⁿ + 27th)
Just over mt # 10 (Wall + 27th)

Arrive by Intersection **1339**
and 27th Streets and Jefferson
Establishing Center of 26th

Monday P.M. Nov 18th 1889

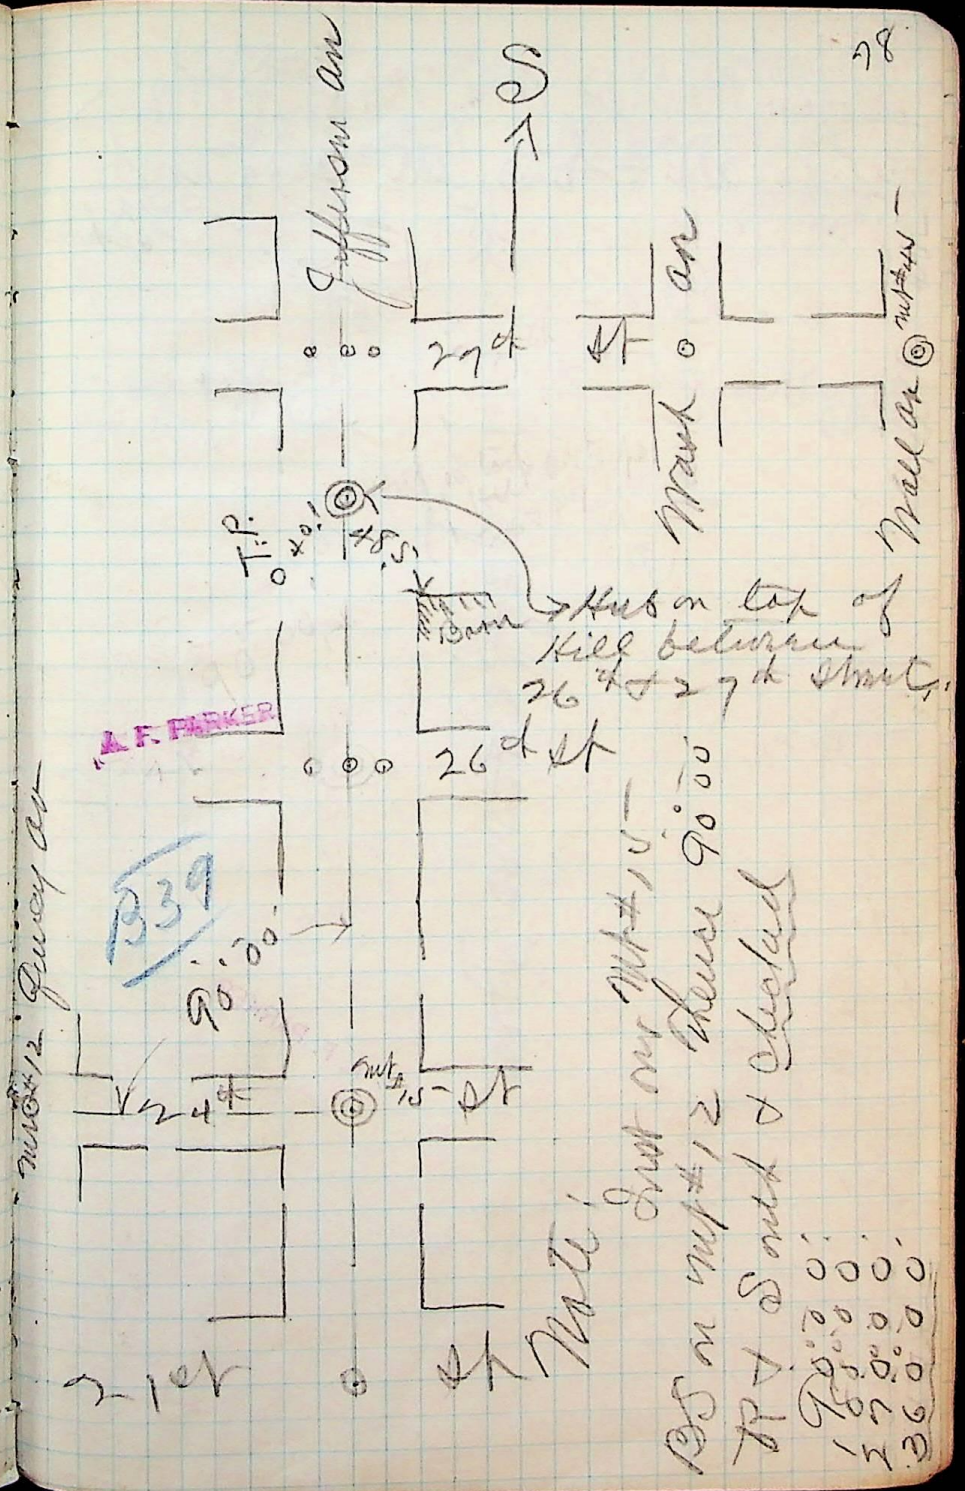

mt # 12 Quincy Ave

Note!

Just over mt # 15
A.S. on mt # 12 thence 90° 00'

27th South & checked

90° 00'
