


Monday Am. Nov 18th 1889
No. 46 No. facing West

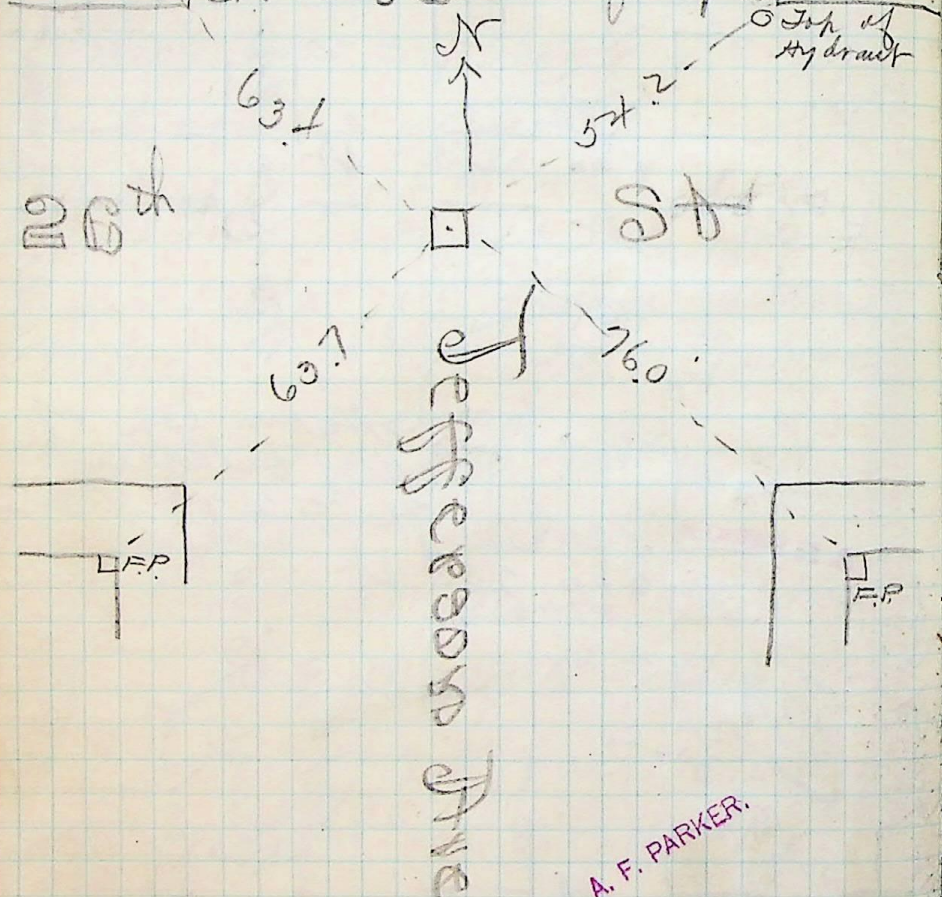

Monday Am. Nov 18th 1889
No. 47 No. facing West

