


Street

Hub on either side @ of 26th & double centered & set there just over this Hub Residence (struck old Hub) of Hill & in front of Barratts and Hub C of Adams on Summit side of @ line of 25th street. Centered & set Hub on either there just over this Hub more in front of Ogden Academy Summit of Hill @ of Adams an double centered & set Hub on P.S. on lot # 27 (Adams + 2, st st)

Just over lot Adams street by Intersection B39 Adams at 25th and 26th street Establishing Center of Adams Wednesday Aug 20th, 1889

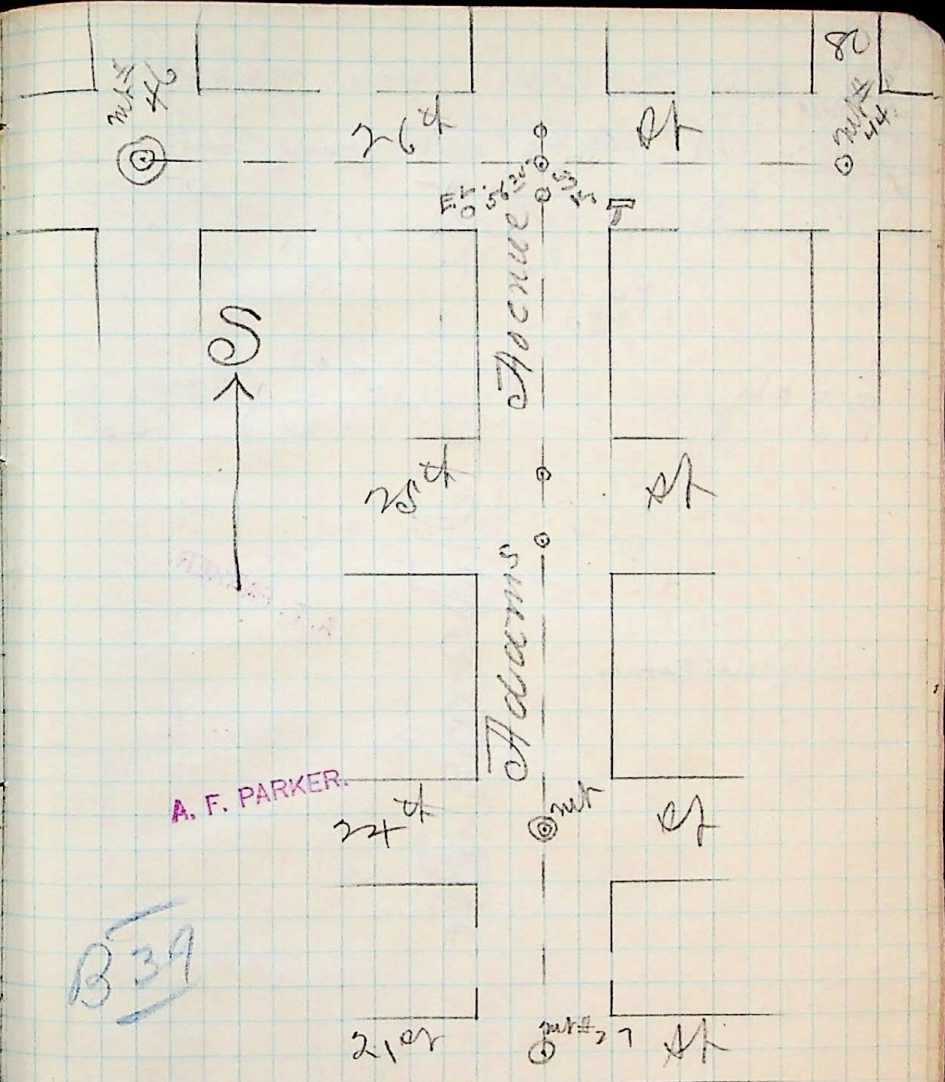

stopped work on top of rain. @ line of Adams (Wall + 26th) Set Hub intersecting Jefferson + 28th & P.S. on lot # 44 there just over lot # 46