B.S. on Mt #28 (Madison & 21st)
Thence Inst over Mt #13 (Monroe & 24th)
line Monroe avenue
Hubs either side 25th & 26th Streets on C
Mt #43 (21st & Monroe) double centered & set
Inst over Mt #13 (Monroe & 24th) B.S. on
Hub for Quincy av line

A. F. PARKER.

F.S. on Mt #12 (Quincy & 24th) & Checked Perkins
Qnd 1/2 way between 26th & 27th Streets
Thence Inst over Hub Center of Quincy
& moved back 0.02 North
uncovered Perkins Hub (of Saturday Nov 16th)
side ~~Ma~~ Center line Madison
double centered & set Hub's either
B.S. on Mt #44 (Wall & 26th)
Inst over Mt #46 (26th & Jefferson av)
by Intersection

B39

at Madison Monroe & Quincy avenues
Establishing Center of 26th Street
Saturday Am. Nov 23d 1889

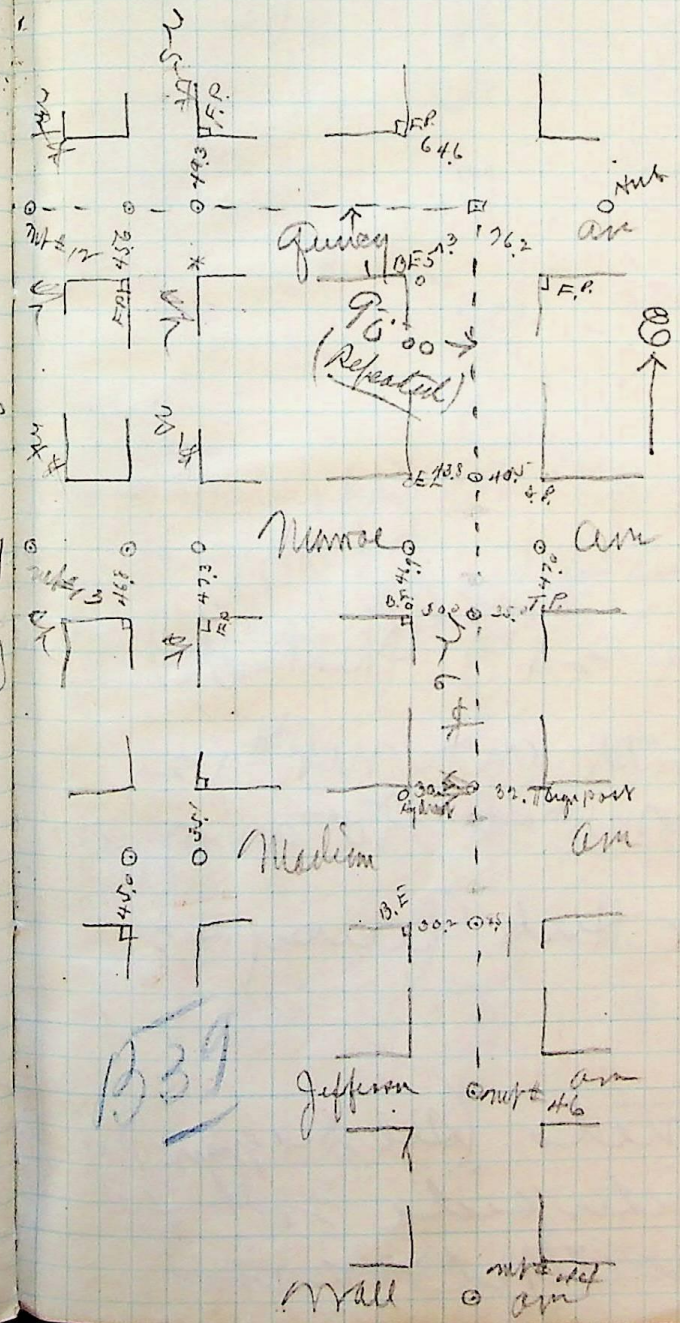

A. F. PARKER.

B39