


Wednesday Aug. 27<sup>th</sup> 1889

Staking out Cross-walls  
at Union Depot

Wall are to set streets  
as per plan on file  
in office

*[Signature]*

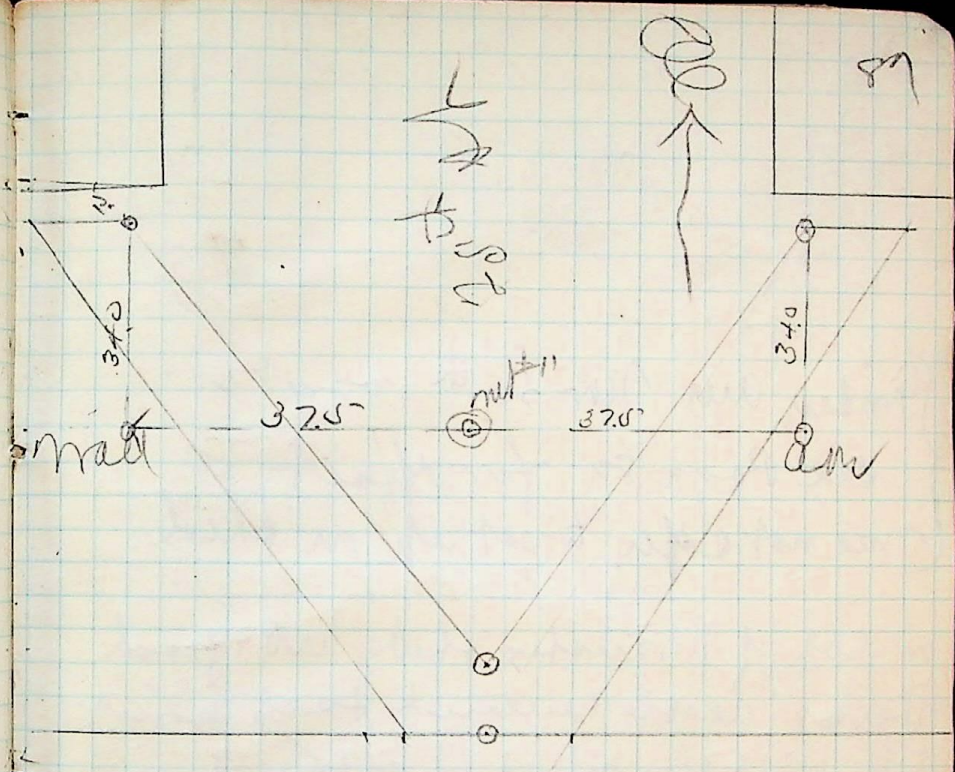

Union Depot