

15+30  
+12  
15  
+8  
14  
13  
12  
+20  
11  
10  
9  
8  
7  
6  
5  
4  
3  
2  
1  
0

Cent on page 92



A. F. PARKER.

57° 20' W (map)


56° 11' R + north AS on Sta 56+00

Point Northwestly

Sta 53+00 on center line 27 ft

Meandering Weber River from

Saturday Am. Nov 30<sup>th</sup> 1889

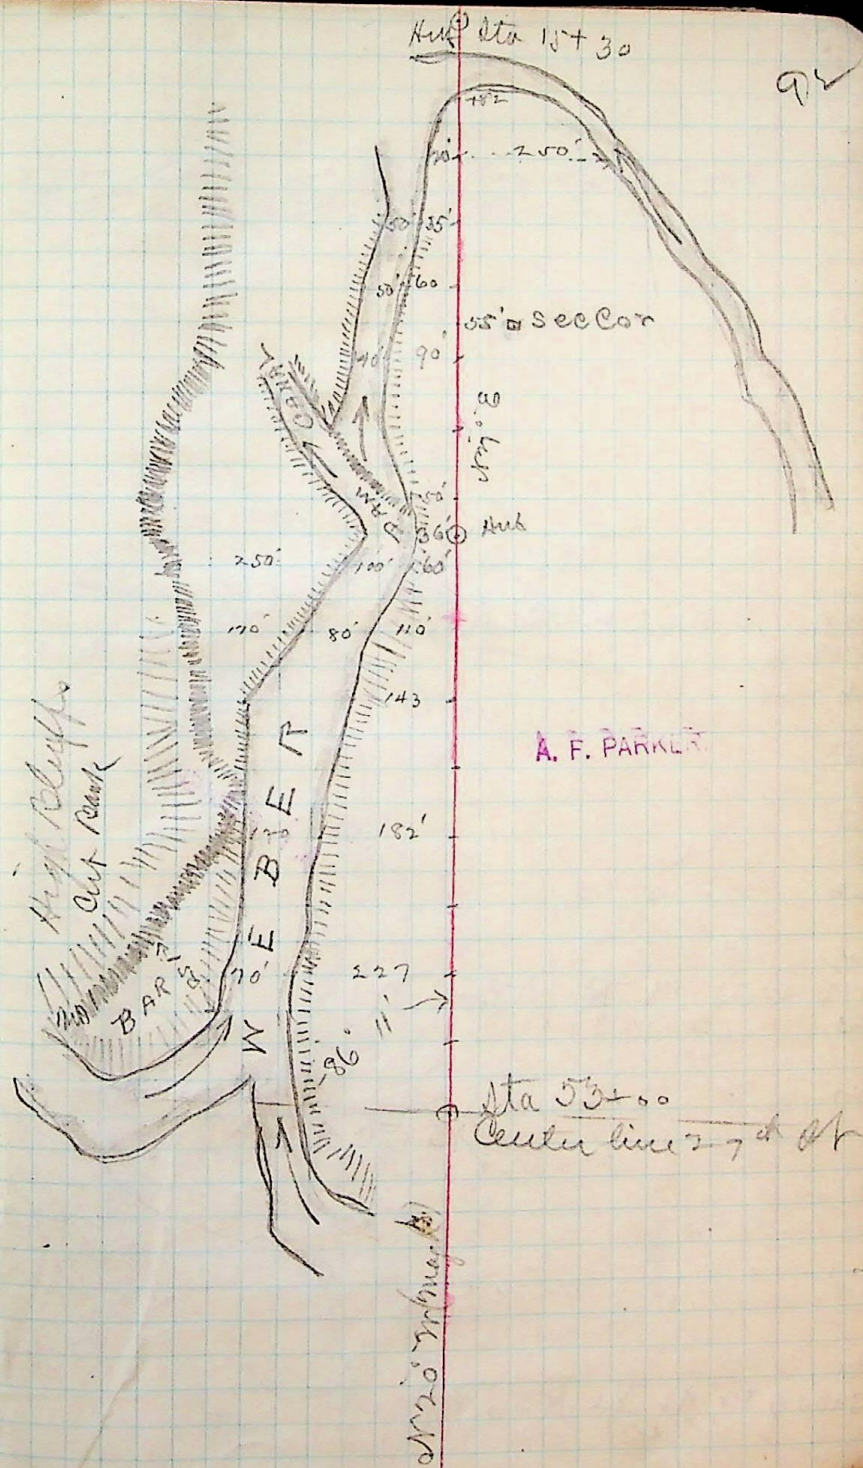

57° 20' W (map)