

For data of this bridge see
J.S. p. 91, M.E. P.

Note:
R.R. bridge
must be
164' long


27
26
25
24
23
22
21
20
19
18
17
16
1500

SRail W.C. R.R.

A. F. PARKER.

34° 19' R (N 21° W)

1500 0 10° 42' E N 56° W (rough)

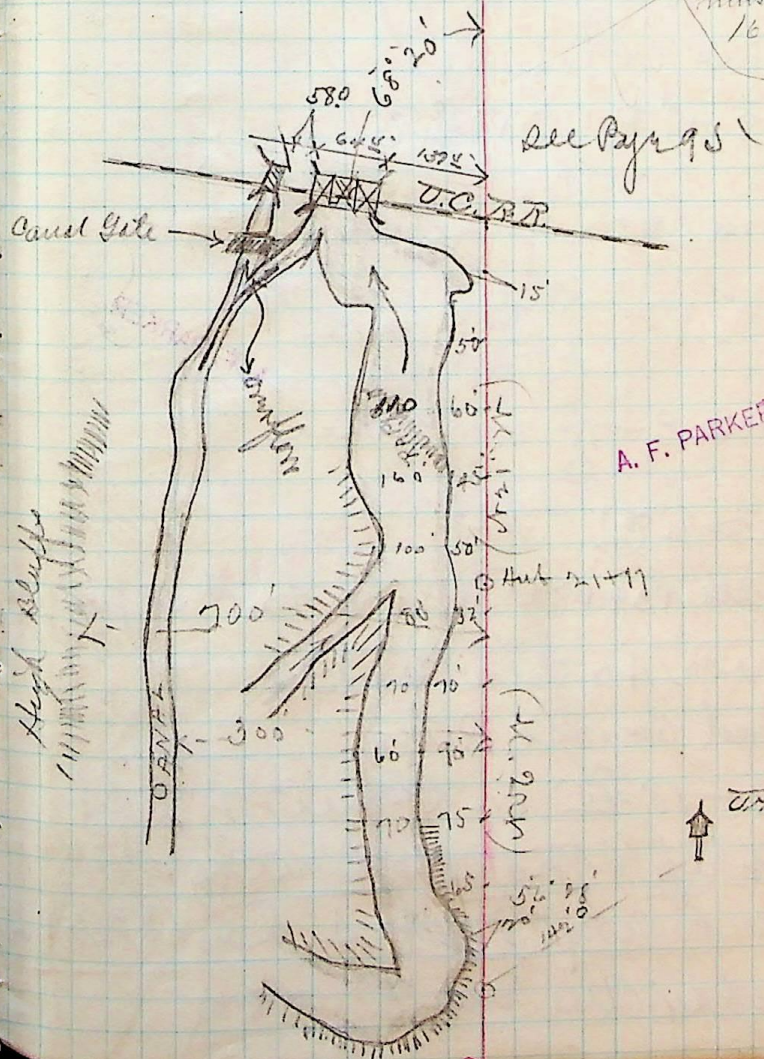

A. F. PARKER.