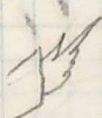


For ties see 


Also Jefferson Avenue
P.M. Set Mt 53 (28th Street)

A. F. PARKER

Streets

Also Grant Avenue 27 to 28th
Street Grant to Wall avenues
Centers for x sectioning 26th

Thursday Aug 26th 1889

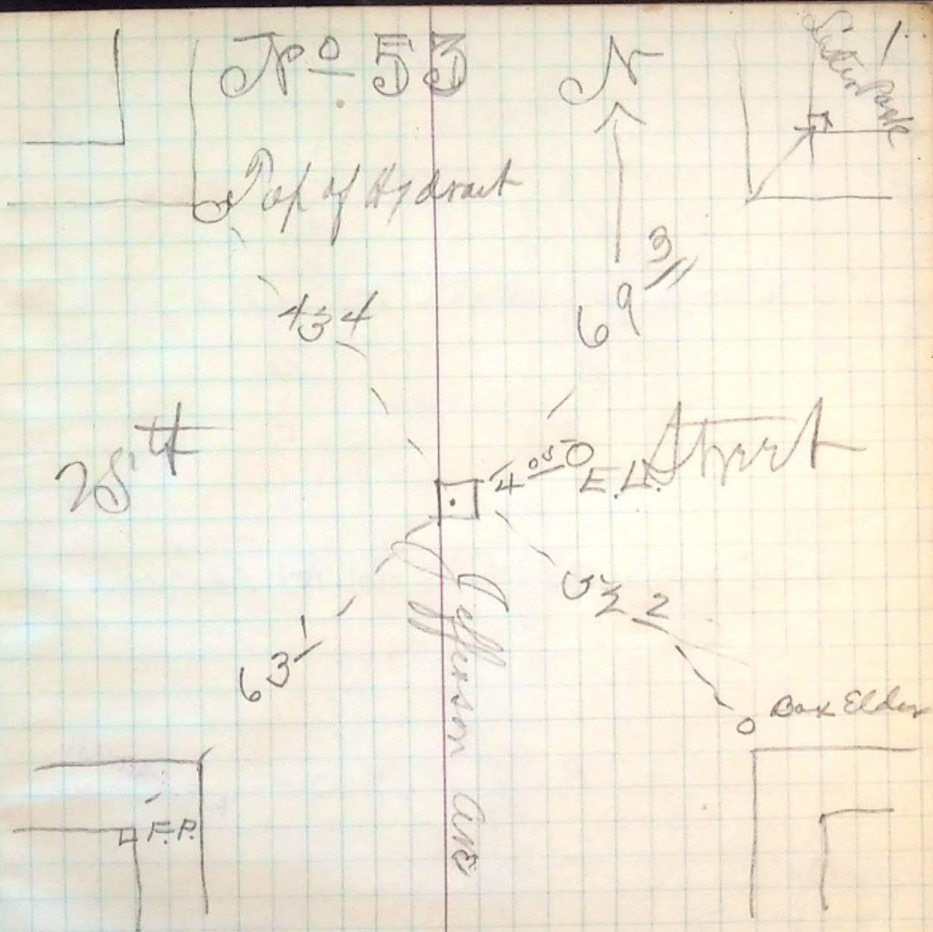

A. F. PARKER