





See Pages 7-9

A. F. PARKER


Arrived 70th - 21st Street
to laying drain pipe Adams
Location of building Imperator
Tuesday Dec 10th 1889

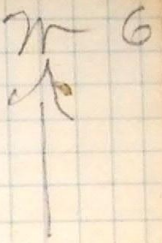

67

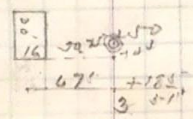


5
450
348
H. H. Chubb
1886

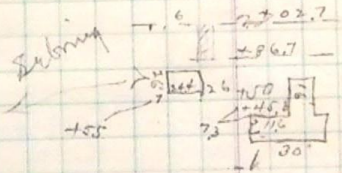

2 / on
158-159

Adams

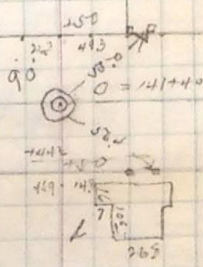

A. F. PARKER

+50
2
+50
Park