+39
36
+30
+15
35
34+44.5
34
33

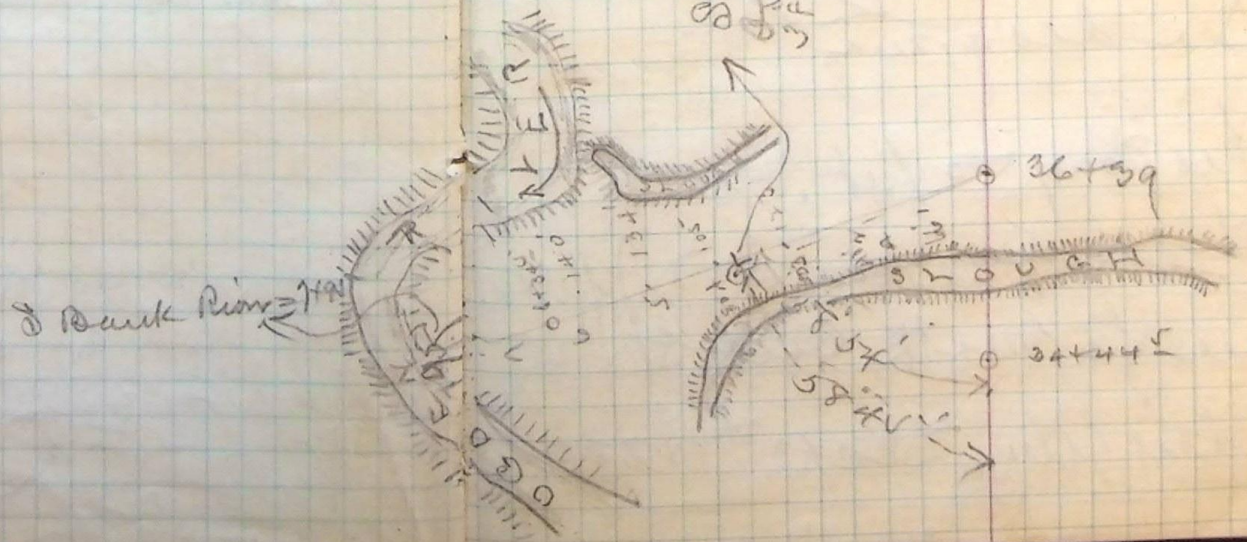

See Cor Sht. on 26+34.5 Angle RT 130° Volumes 3 FOR ½ = Sec Cor

See Page 17

A. F. PARKER