


Jefferson Ave

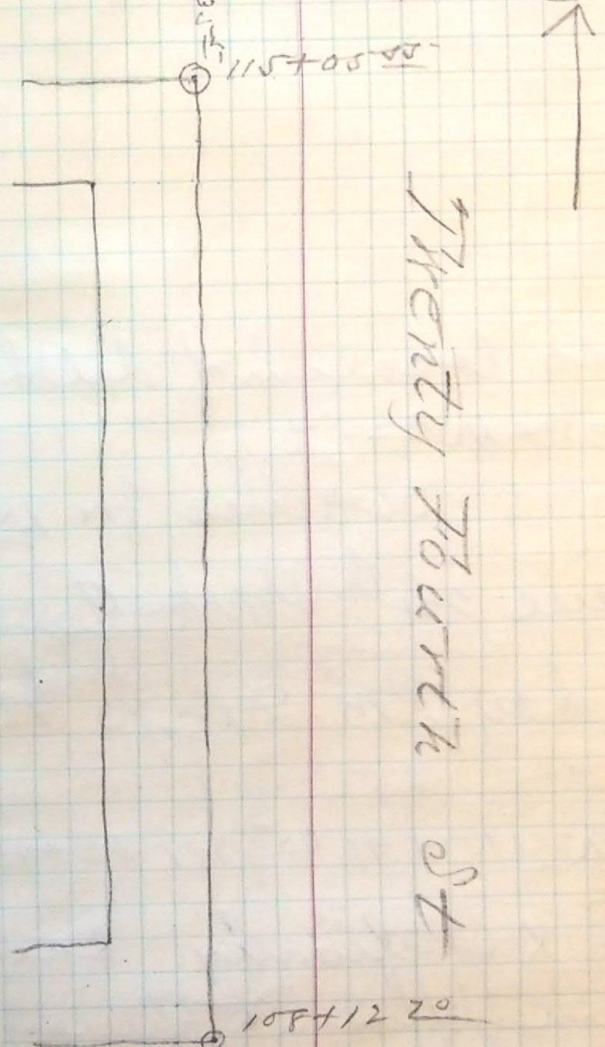

Adams Ave

PS not 5' north of it

See diagram

Stakes every 50 feet.

24th St Street Adams to Jefferson  
Since for north cut

Friday Am. Dec 13<sup>th</sup> 1889