


1339

A. F. PARKER.

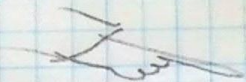

for reference see diagram
of 23^d & 22nd streets
& set hubs on S & on street lines
AS on Hub 28 (Madison & 21st St)
on 2nd Street

Just over Hub 14 (Madison
& Planting Monument,
for Intersections preparatory
Side Line 23^d & 22nd Streets
Madison Ave and on other
Setting Hubs on Center Line
Monday Aug. 22nd 1889

1339

21st

A. F. PARKER.

22nd








FPK

23^d



24th

Hub



Madison

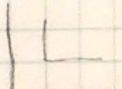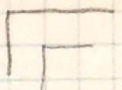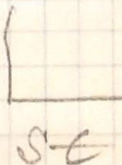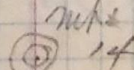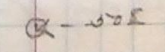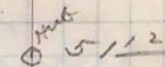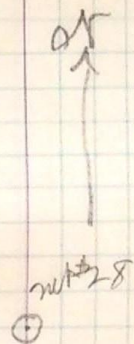

SE

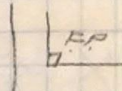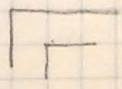

SE

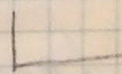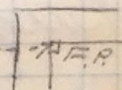

SE

mt