+63

29

28

27

26

25

+19 ⊙ 3° 13' R (Deflection R) A. F. PARKER. Cal Course N 43° 09' E

24

23

22

+19.5 ⊙ 67' 24' R. Deft) Cal Course N 39° 25' 6" W

21

20

19+00 ⊙ 6° 28' R Deft (N 13½ E) C. Course N 23° 0½ E

18

17

+90

16

A+5 fence

B.S. on Ctr ⊙ 112° 04' R Deflt

15+10.4 ⊙ Customs Rail Joint up the North Bank Ogden River

Continued on page 30

A. F. PARKER.

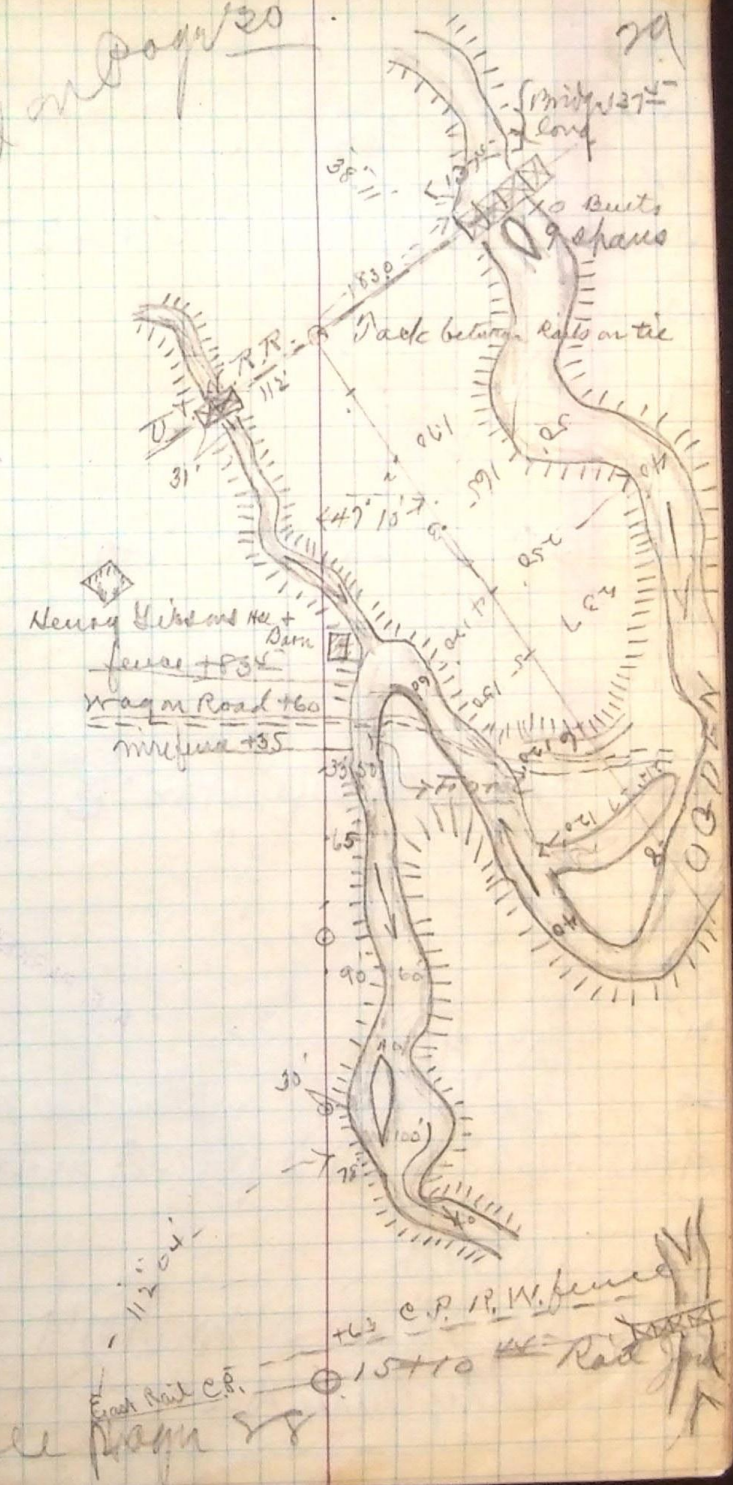

See Page 28