A. F. PARKER.

to Sta 103+50
Hubs every 50 ft (on ever Station numbers)
Sta 141+35 - 90° L & next set
Adams ave (N.E. cor) B.S. on
at intersection of Curbs 21st &
pipe (10") Thence Inst over Hub
141+35 = C of manhole & end of
50 ft (on ever City Stations) to Sta
of 21st Street thence set Hub every
distant 35± for North Curb line
on Mt # 8 90° R & North set Hub
Curb line Adams ave Thence B.S.
tered & set Hub distant 35± on East
Inst over Mt # 27 B.S. on Mt # 8 double cen -

Tile Adams ave & 21st
Staking out line for Drain
Monday Aug. Dec 30th 1889
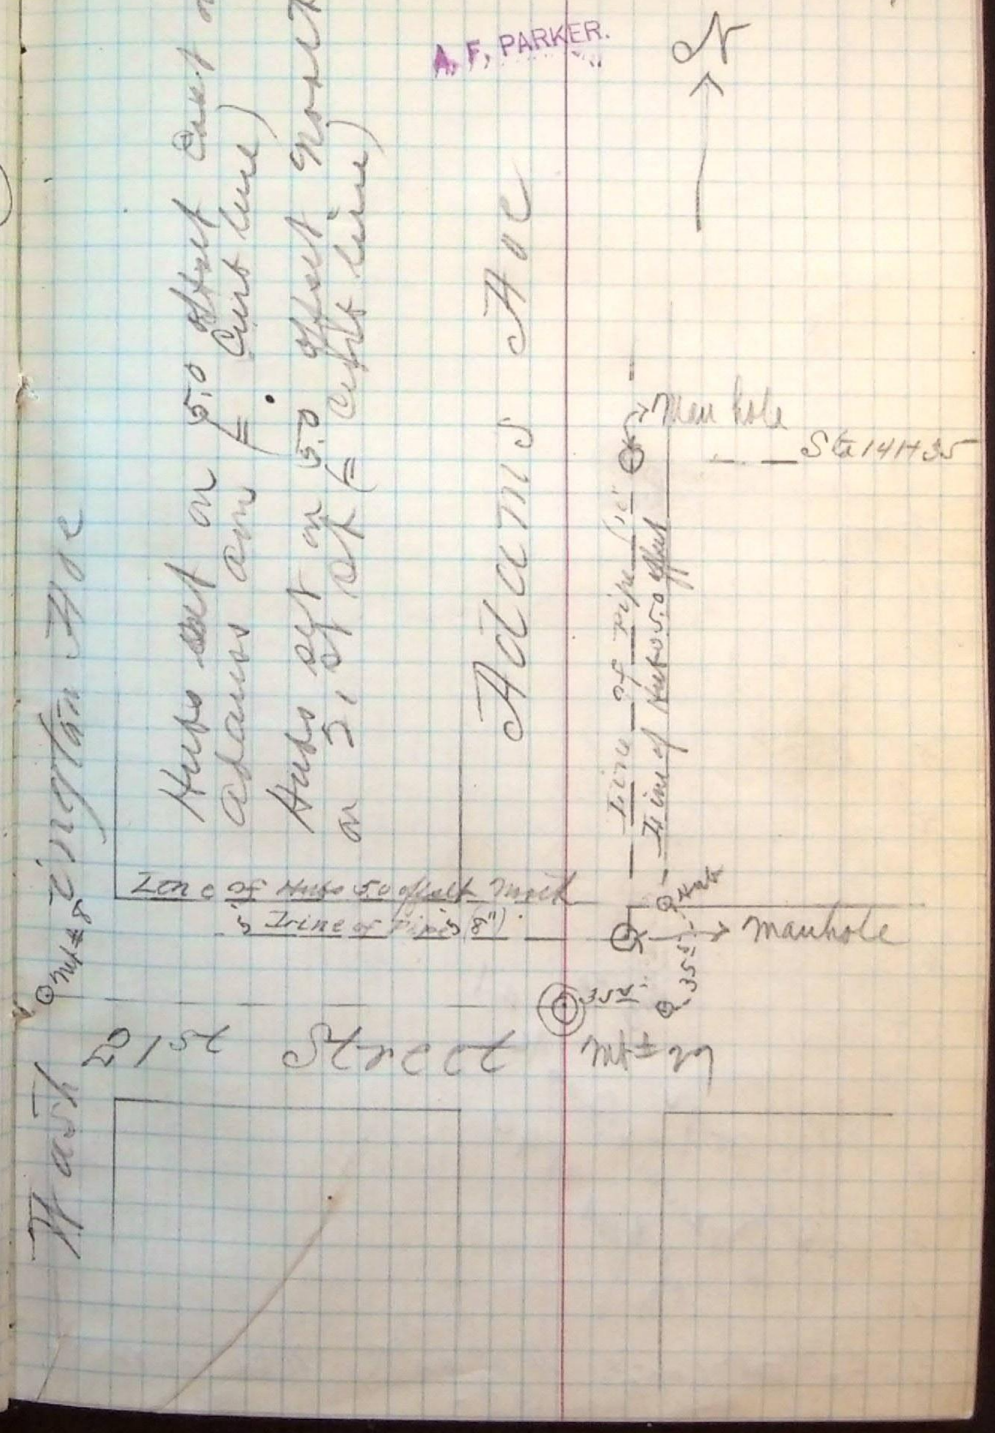
A. F. PARKER.