


4  
(C.P.)

3

2

1

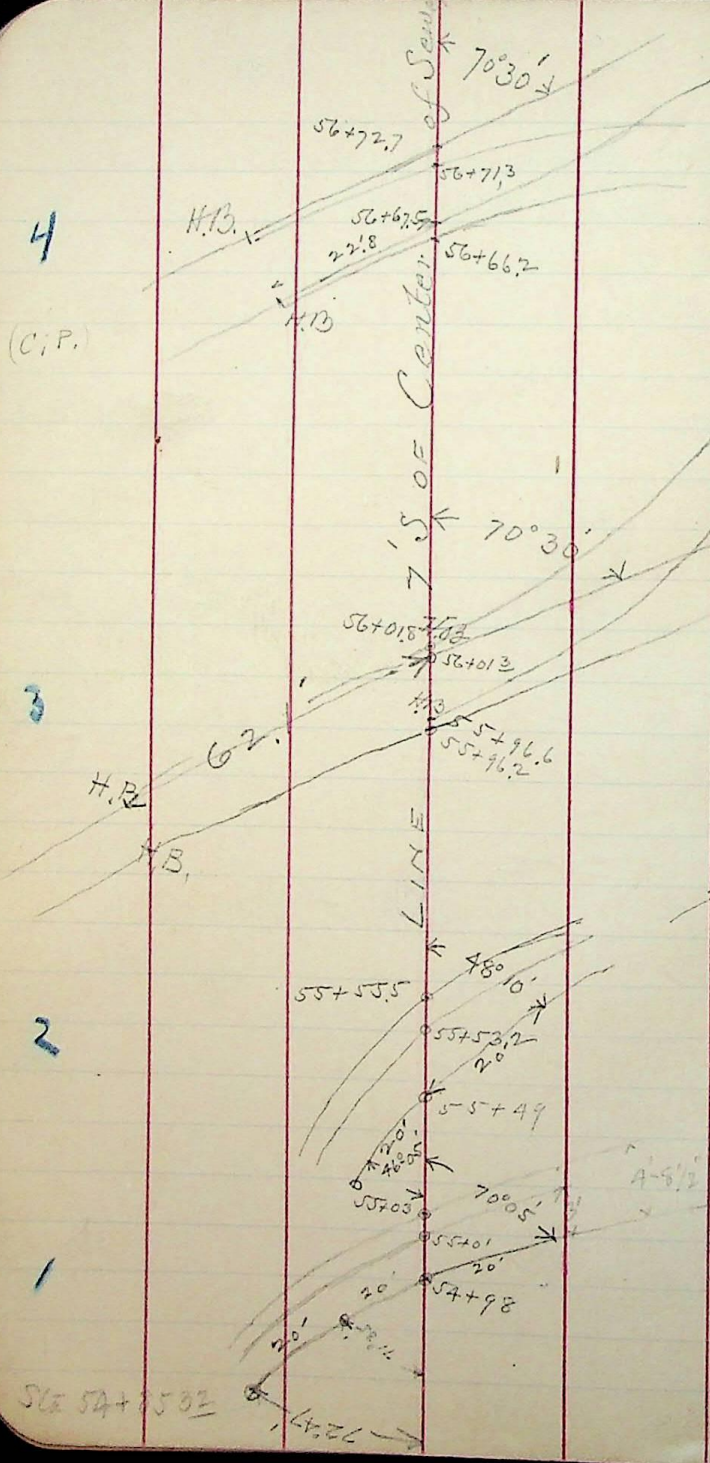

J. M. Sept 13-90

P. M. Sept 13 to 1890

5

