

Set Stakes for Sewer Grades  
Sta 51+90 to Sta 52+80

A. M. Sept 15<sup>th</sup> 90

Mt  
21<sup>st</sup> + Hall.  
©


Crossing of Tracks

Hall & 22<sup>d</sup> St. Notes taken  
on Center of Sewer 15' W of Wall

For continuation  
of notes  
of this track see  
P 17 of this Book.

A. M.

Sept 16<sup>th</sup> 1890

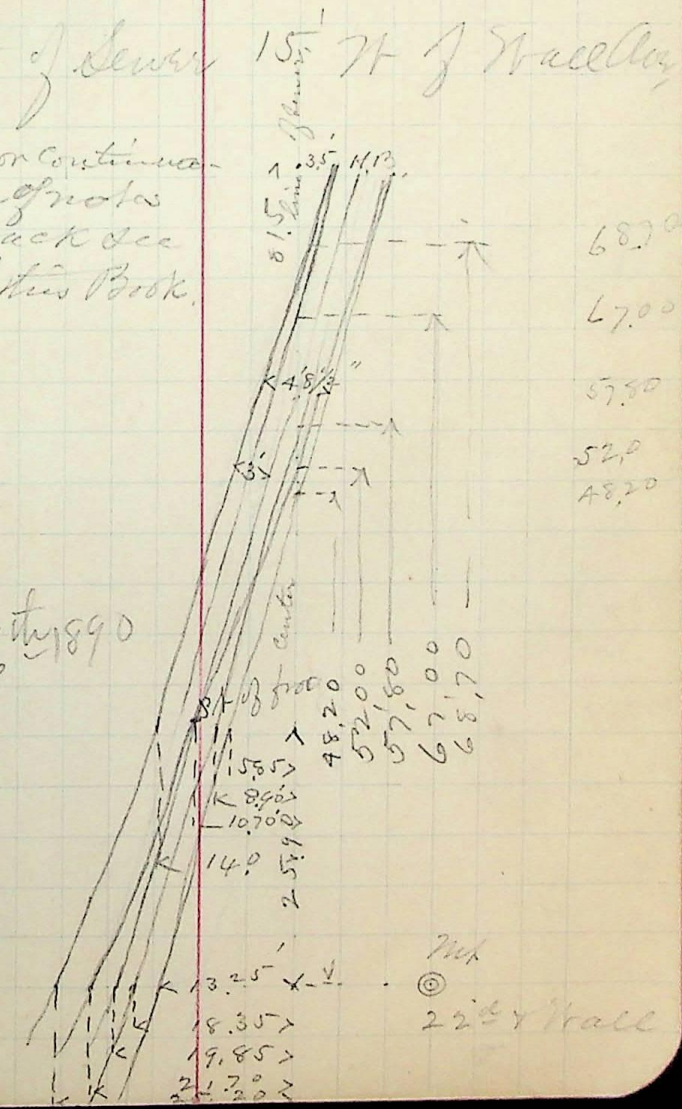

Mt  
©  
22<sup>d</sup> + Hall