
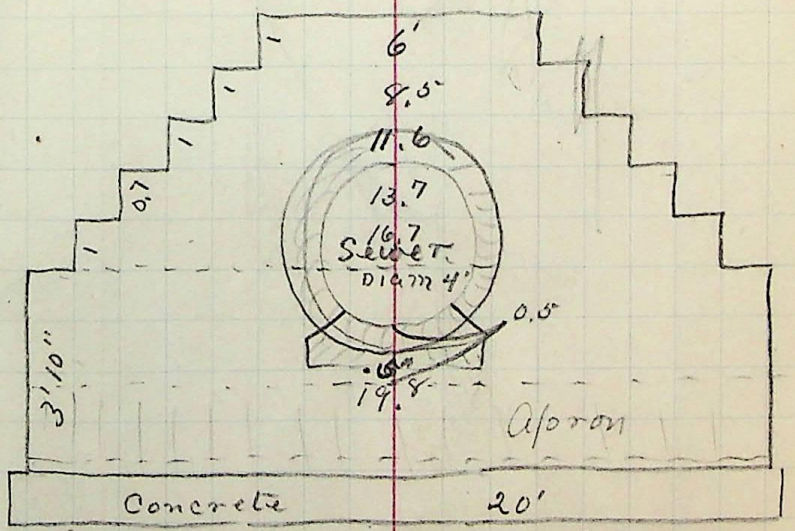


Measure of completed  
 about Sewer discharge  
 Sept. 15 - 1890  
 W.P.

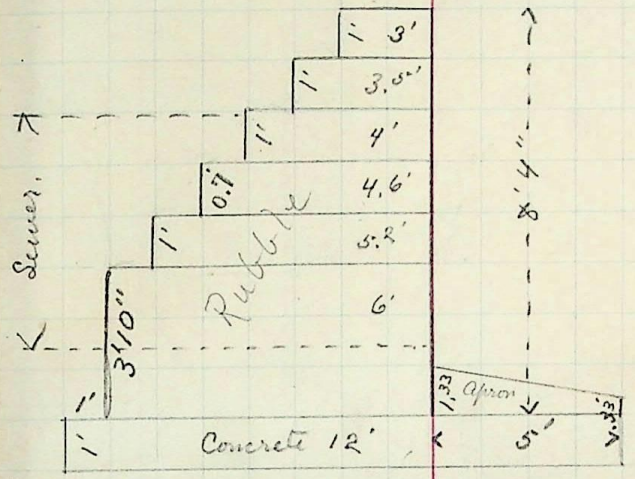

Excavation  
 Concrete  
 Rubble Masonry  
 Stone Spl.

27	Cu. yds	40 <sup>¢</sup>	10.80
9	Cu. yds	3.00	27.00
19.5	"	4.50	87.75
			20.00
			<u>145.55</u>