Continued from Page 14
Utah Northern Tracks.

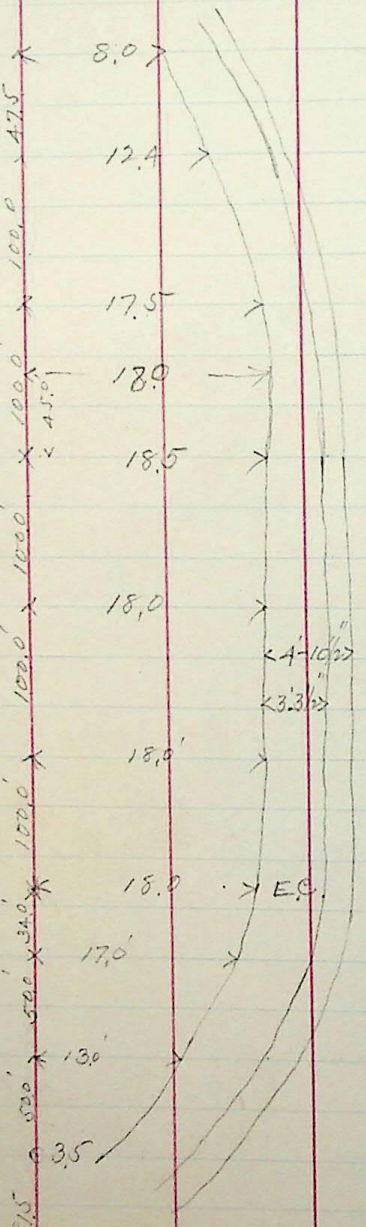

Sept 17-90

Sept 21 St St.

Set Stakes for Work
Grade Sta 57+47.95 =
54+40.60 to Sta 55+20

P. M.

Sept 18-90