Set Stake for Invert Grade at Sta 137+30.

A.M. Oct 17th 1890

Set Stake for Invert Grade at Station 137

A.M. Oct 18th 1890.
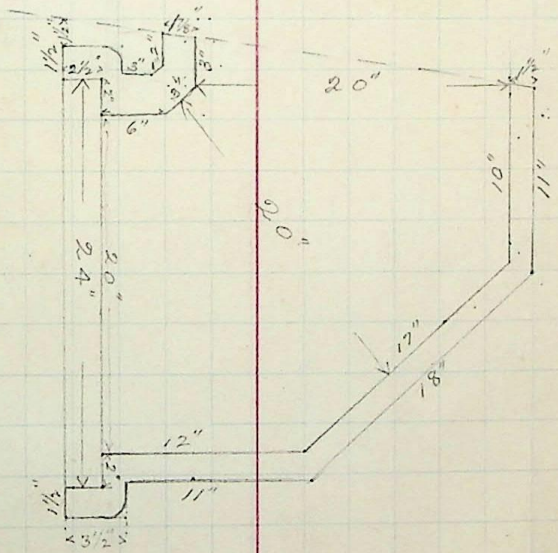
Sketch of Siphon Elbow under Plank City Canal.
Oct 20-90