


Stakes on 48" sewer
 N on 21st St. S

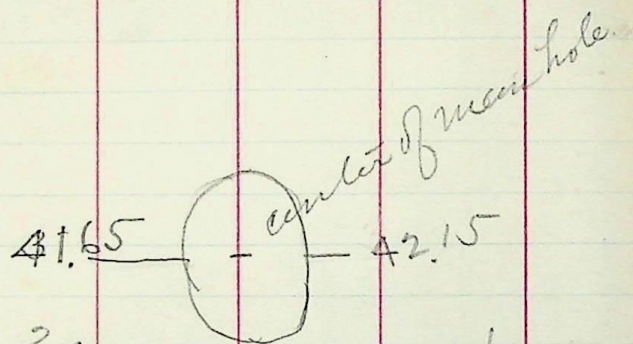

25.52	25.04
23.80	24.18
24.65	24.95
25.07	24.65
25.30	24.90
24.60	24.60
25.83	25.53
25.00	25.23
24.58	24.92
2.02	1.95

Nov 19-90

beg - E. Face of arch at Man hole.

back stakes to grade top of trench
 for 15" pipe
 on 23rd St from Sta. 81+40 to 84+55²⁰

From Sta 84+20 to Sta 84+40²⁰
 = Manhole center the distance is 20⁴
 instead of 20²

A. M. Nov 20-90