


Stants on 3/4" base.
 On Wall air Apr 9-91.
 N. Side E. Side

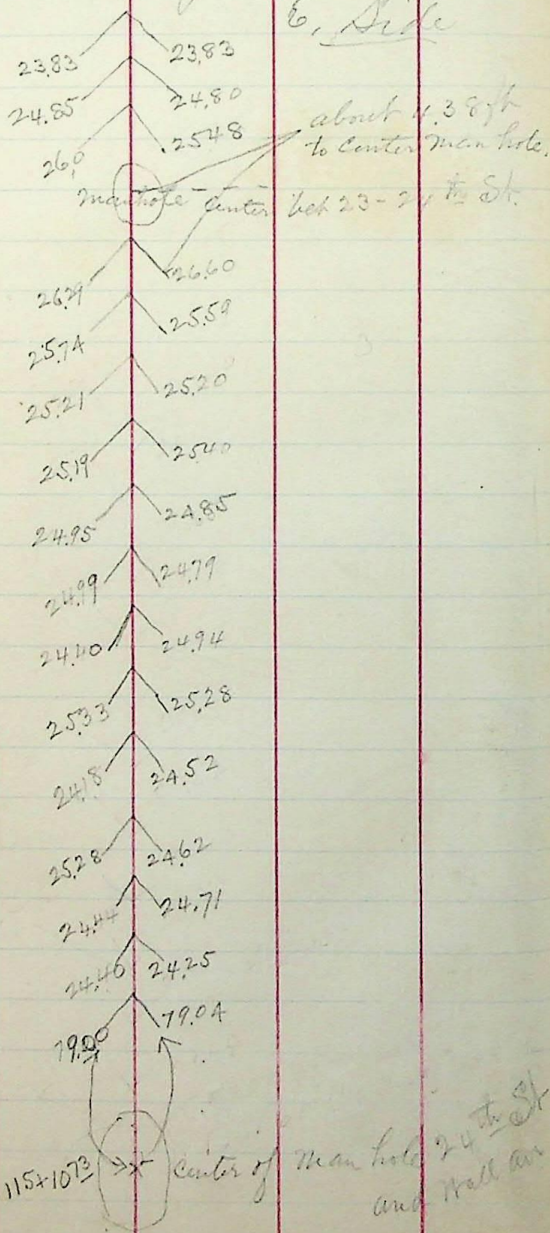


This block OK
 should be finished
 Considerable wind in bottle

Sta = 115+107.3

3372
 23.06 76.78
 N. Side

E. Side

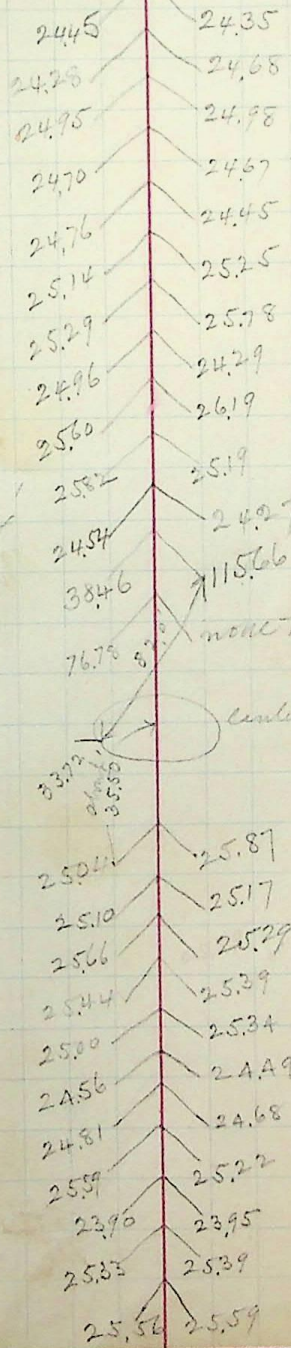

Beam down 300'

This block OK