


Slants in 36" Snow.

W. Side

E. Side

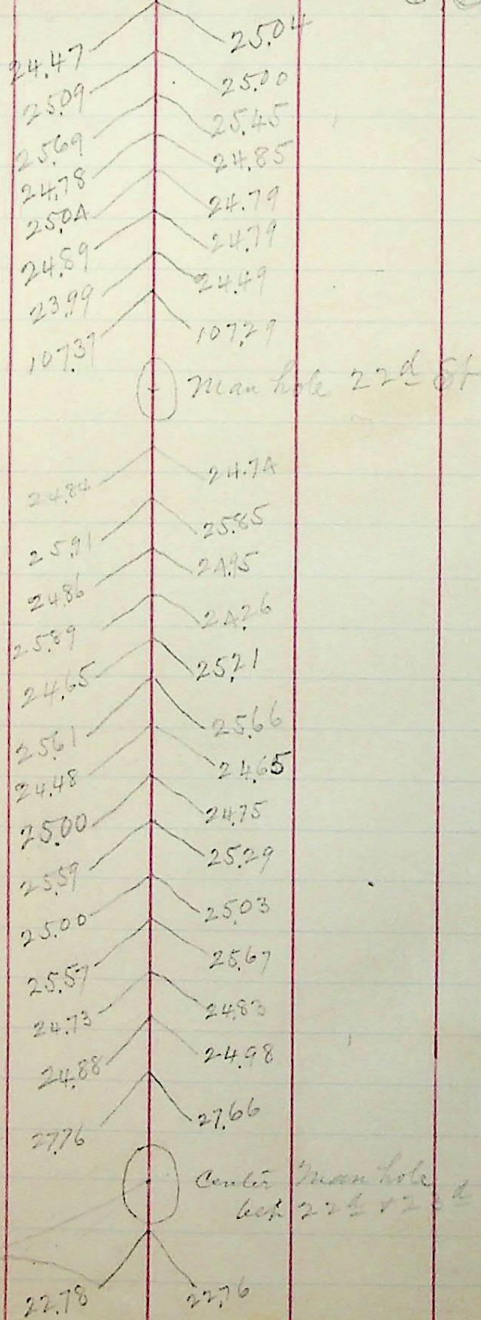

231

763 7 762
107 37 31
107

1645
2179
729

53

W. Side

E. Side
(1.4)

(4.75)

