



Sta	135+00	○
"	130+00	○
"	125+00	○
"	120+00	○
"	119+06	○
"	115+00	

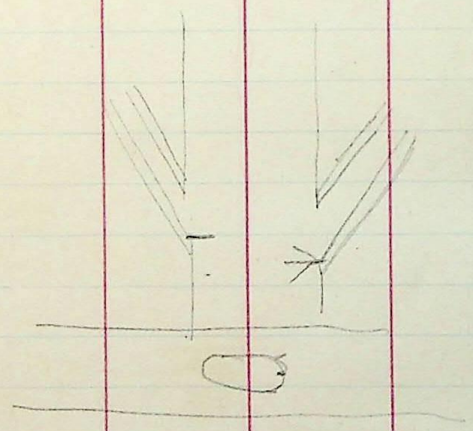

Preliminary Sewer Alignment
 - Old Notes -

32+29⁶⁸ A.R. 19' 30"
 35+36⁹⁵ Chisel Pt on S.E. Rail P.S. Hub
 40+00 - Hub
 46+27⁹³ "
 49+79 Ditch
 50+00 Hub
 51+73 Edge Plain City Canal
 51+83 E. " " " "
 51+89 Hub set for Meander of P.C. Canal
 From Sta 32+29⁶⁸ to 54+49⁶¹ Center
 line of Sewer is 15' North of Center line
 of 21st St - from 54+49⁶¹ to Sta 76+90²
 (Center Hall Ave) center line of Sewer is
 15 ft South of Center of 21st St.
 54+49⁶¹ Hub 15' North of Int.
 54+49⁶¹ Hub 15.76 South of Int.
 65+00 Hub.
 70+00 Hub.
 76+90² Race Ave

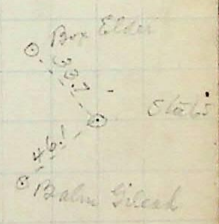

See P 50 Transit Book 2A