

53
52
51
50
49
48
47
46
45
44
43
42
41
40
39
38
37
36
35
34

① 18° 30' R. (left) S 21 3/4 W Cal Course S 38° 38' W

② 79° 30' Δ left S 3 3/4 W Cal Course S 20° 28' W


③ 37° 30' Δ left S 82 3/4 W Cal Course N 88° 02' W

④ 58° 30' R. left N 65 1/2 W Cal Course N 48° 02' W

N.S. Induced = 90° to edge bluff

W
B
R
O
S
H
U
S
H

200 S to N.A. (New line it)
130 S to N. Rail

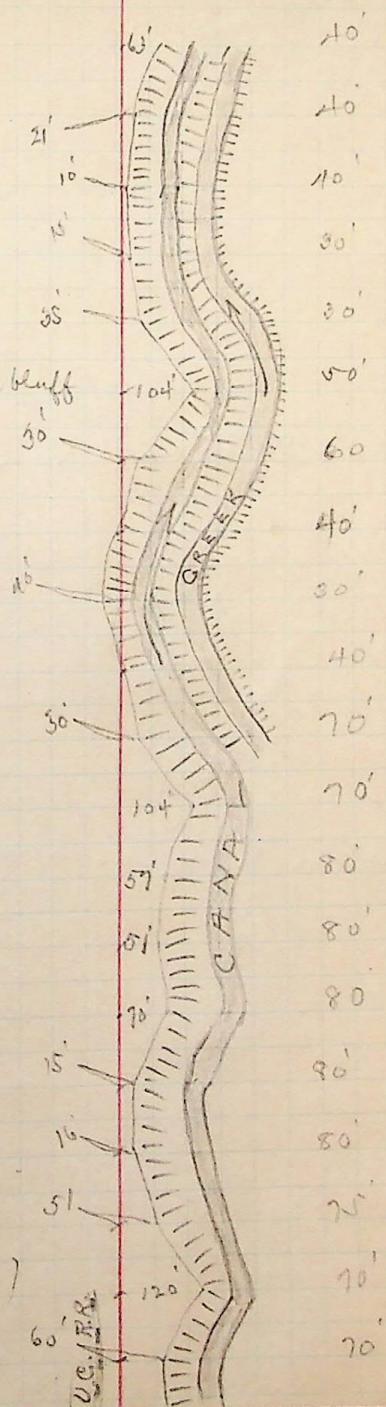

M.F.A. D.O. FR.