

Back up to Sta 5

10

9

8

7

6

5

4

3

2

1

105°00' S 8 1/2' E S 89°32' W

43°30' R left N 82° E N 66° 25' W


S 70° 02' W = 0. P.

0 = Sta 3 + 23 ± of Weber River meander south of Sta 5


See Page # 37 + 38 Transit Book # 11

Meander of Weber River Continued

Friday Aug. Jan 17th 1890

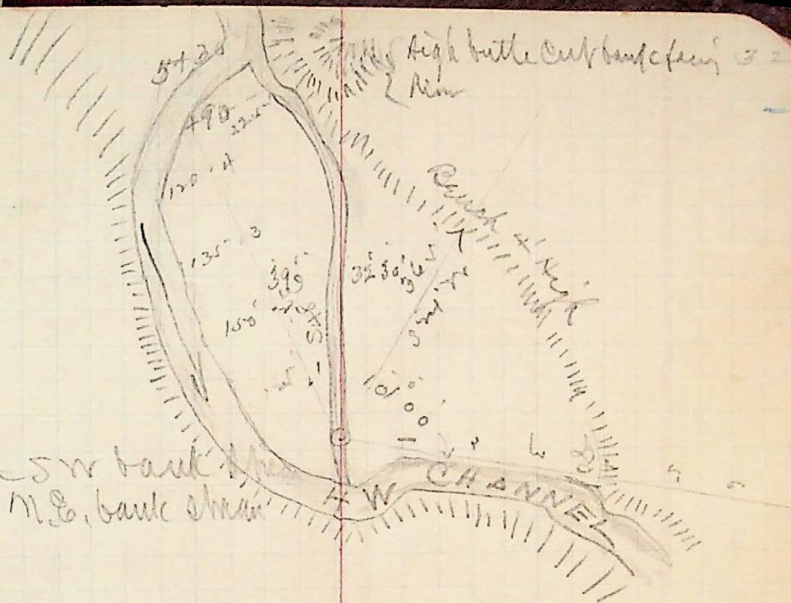

at 70 = SW bank of
at 15 = N.E. bank of

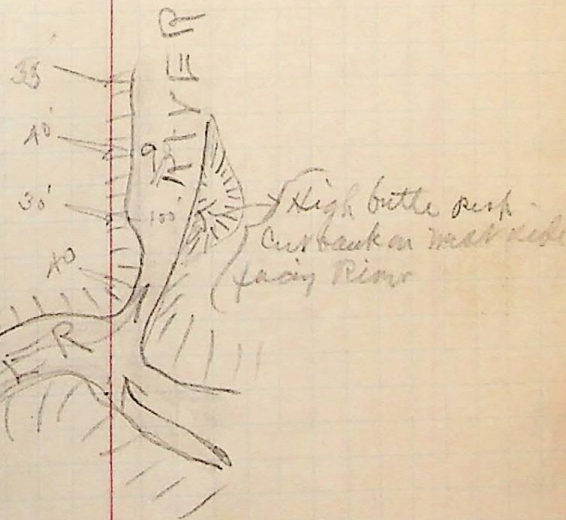

1450 = N bank of