

25  
24  
23  
22  
21  
20  
19  
18  
17  
16  
15  
14  
13  
12  
11  
10  
9  
8  
7  
6  
5  
4  
3  
2

12:30 0 15° 00' In left 58 1/2 W


16:30 Re left 76 7 1/2 W

12:00 In left 71 1/2 W

09:30 In left 72 1/2 W

10:30 Re left 72 1/2 W

7:00 0 15° 00' Re left 78 1/2 W

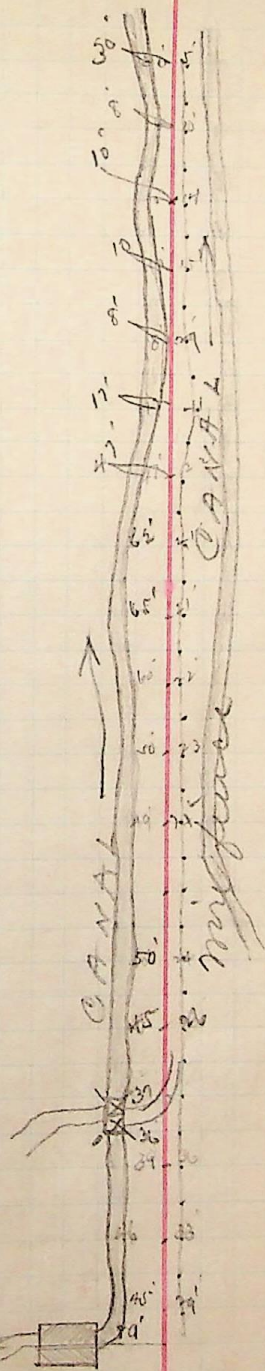

Post a mill to double line and outboard over canal on the U & C Ry