

of old Cemetery. box drain
See diagram for location

52 ft x Sta 145+00

141+00 set Hub + thence com
Hub 141+30 thence at Sta

Just over Hub 138+00 = F.S. on

Series 1889

See page 42 Transit Book #7


drain box) Adams am 50-21

and location of old Cemetery

Setting centers for tile drain

Saturday Am, Feb 1st 1840

20th

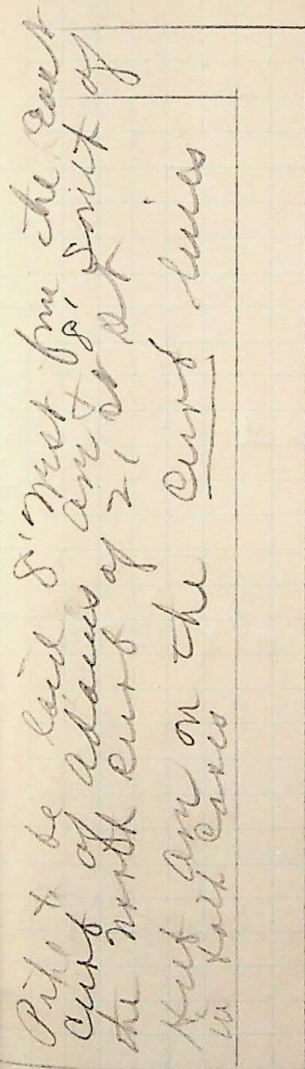

Adams Ave

1-8" pipe

21st Street

Street 53

145+00

2-4" cement pipe

144+35

1-10" cement pipe

138+42

2+0+30

Manhole

Manhole

Hub 138+50