

$109^{\circ} 59\frac{1}{2}'$  = to west rail U.P. main line  
on mt #19 Angle R + South

thence Just out this Mt B.C.  
north C line 28<sup>th</sup> St. = Sta


Previously set either side 10<sup>o</sup> offset  
P.O. on mt #19 + subselected hubs

64490<sup>2</sup> = east rail <sup>main</sup> melody track  
line 28<sup>th</sup> St - thence into over Sta

Hubs either side of 10<sup>o</sup> offset North Center  
P.O. on tang Smith double centered + set

U.P. R.R. South of 28<sup>th</sup> St (crossing on Over)  
Just out west rail main track

Wednesday P.M. Feb 12<sup>th</sup> 1890

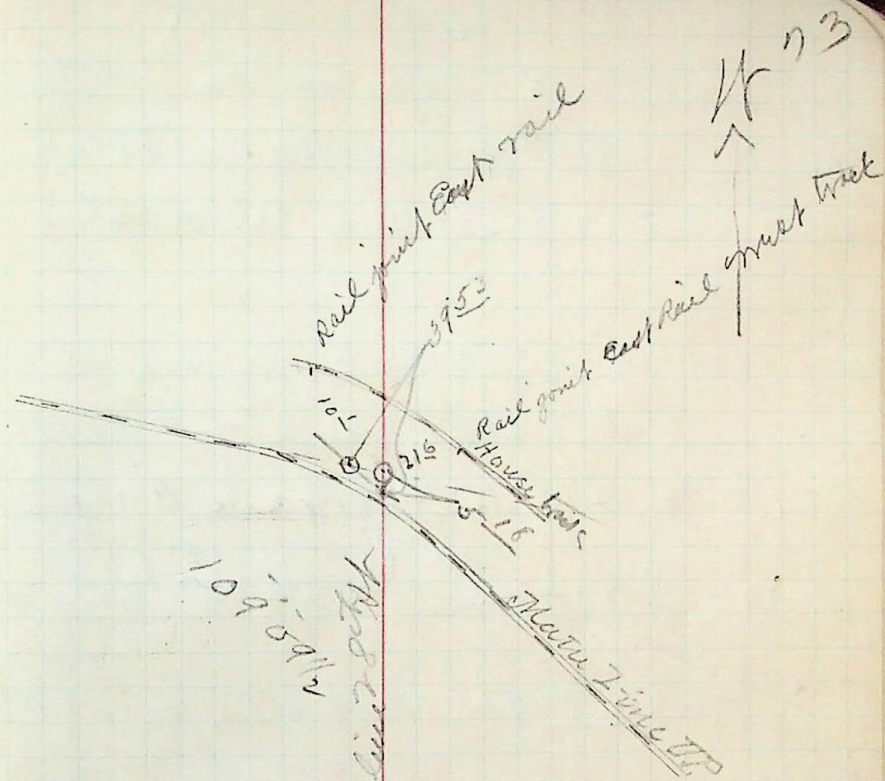

mt #19 Hall Hole