


side Grant and to north pt  
 Blk 25 Plat of Ed along the Eastern  
 Location Tile Drain through  
 Tuesday Am. March 4<sup>th</sup> 1890

mt 31  
 1/1/202

115702 = c mt of sewer or drain

234

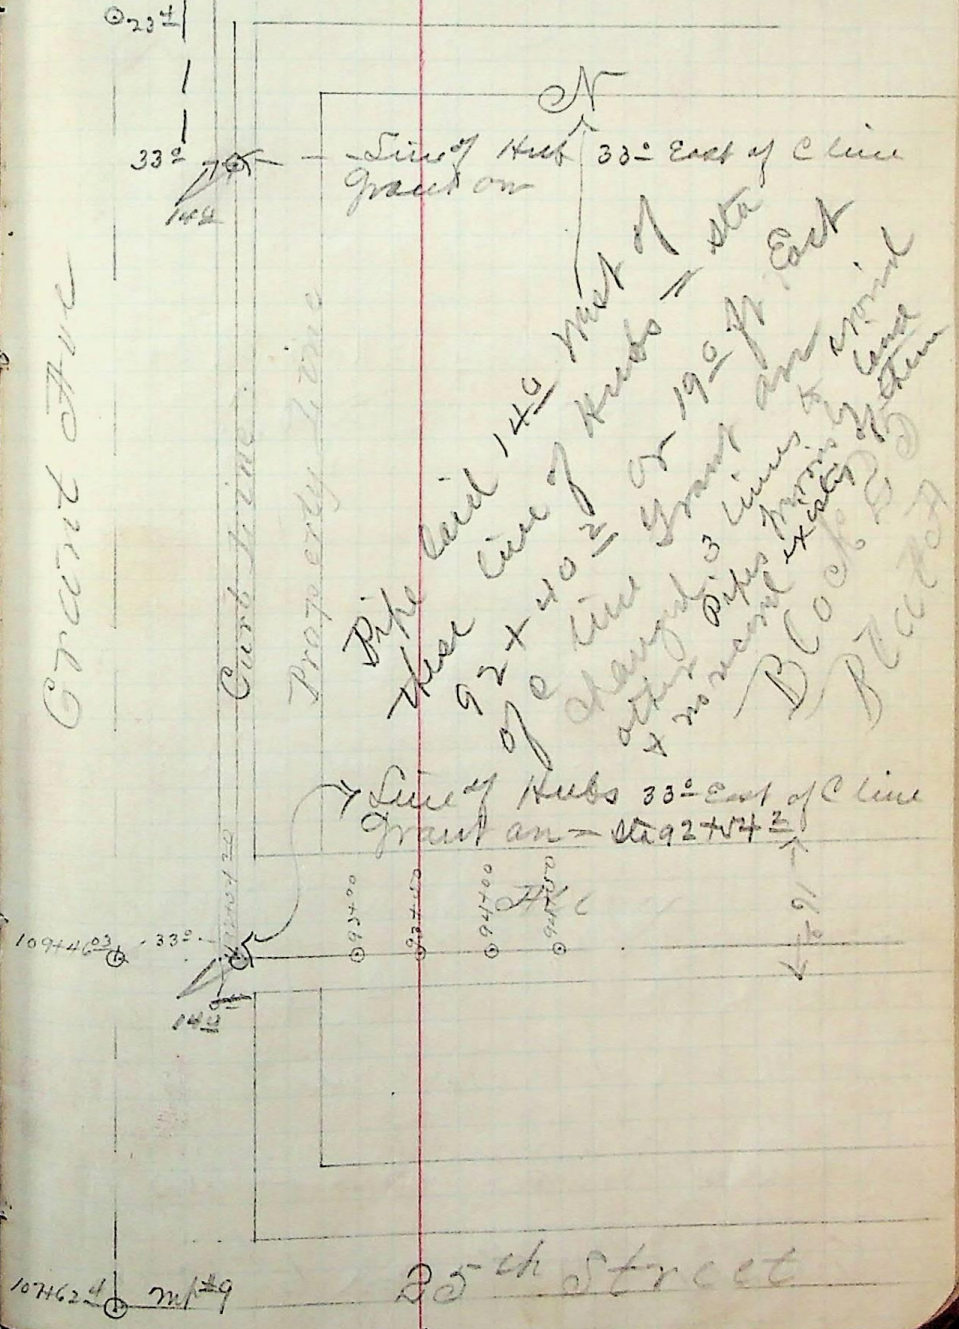

811