44+38 Center Weber Canal

44+18 Cross Road
44+10.85 E & W fence

43+96.46 = Hub & tack 1° R

42+92.85 ⊙ Set Hub

39+52.85 Cross fence E & W

107+95.04 ⊙ B.S. on 103+14.77 Angle R & North 89° 34'

812.5 Cross N & S fence (on B.T.)
107+95.04 ⊙ Set Hub

103+71

103+51

103+14.77 ⊙ Set Hub. Thence double centered + at
at Sta
100+40

99+90 ⊙ Inst over Mt# 34 B.S. on Mt# 15 90° R & E (Repeated)
also Location of N.W. Cor Blk 5 + N.E. Cor Blk 6 Lakeview addition

Same with City Mt# 34
T 5 N & R 1 W + Connecting
Location N.W. Corner Sec 4
Thursday Am. March 6th 1890

Note - June 8 1890
By O. Winchingstad
Mon. B, E to Sec. Cor
787.64 ft.

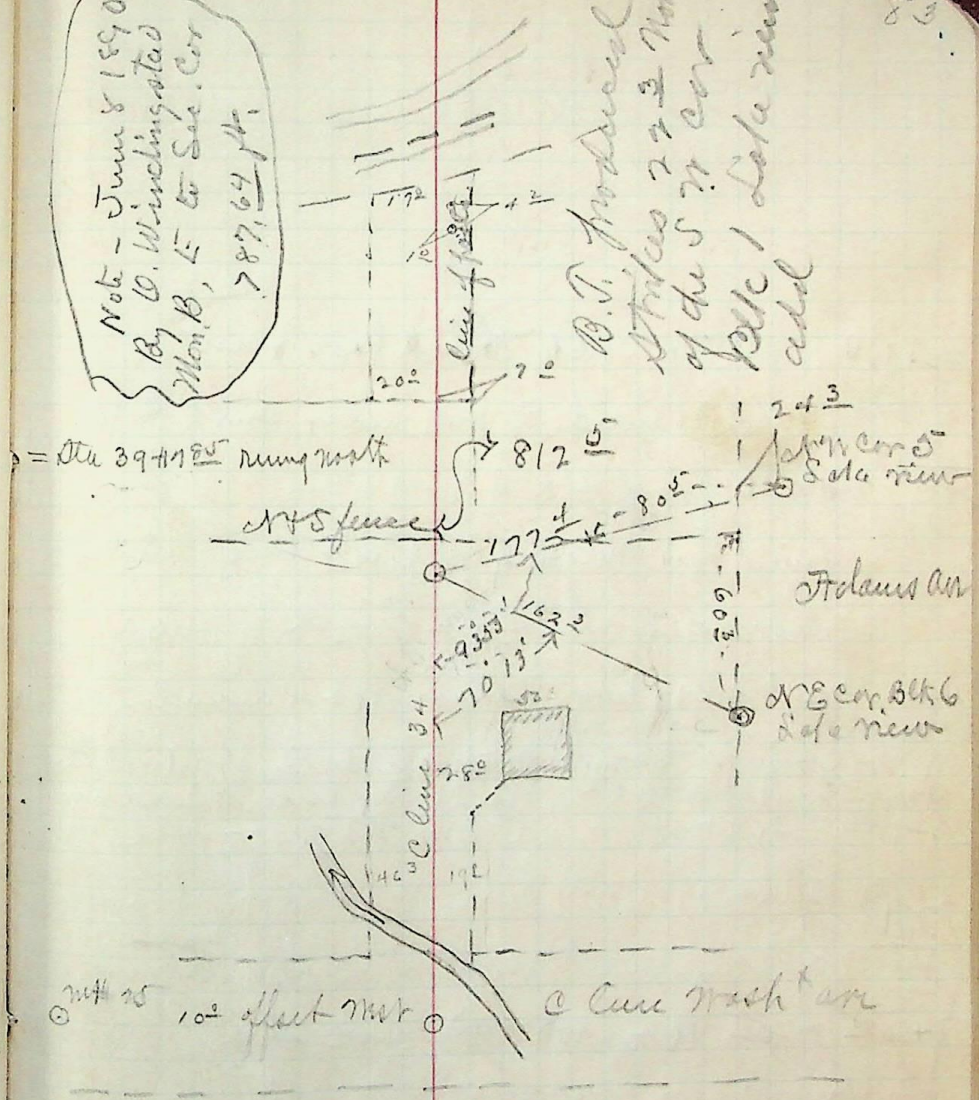

Measurement made with 100° Steel tape